
LCP COMPRESSOR

Enclosure Specification		
Tag number	LCP-2101X (Note 1)	
Marking acc to 94/9/EC directive	Ex II 2 G D	٢
Marking acc. to IEC	Ex d IIB+H2 T4	Shall be modified comment on page HY reply:Page 11 modified. This size is intern
Ingress Protection to IEC 60529	IP66	LCP & 2.5mm2 is
Permissible Ambient Temperature	5 °C TO 55° C	
Material	Copper Free Aluminium	
Colour Of Enclosure	RAL 7035	
Thickness	Minimum 3mm	Consideration shall be given that the that it is necessary during test of eq HY reply:Confirmed.

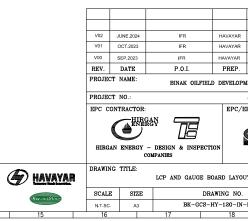


Kw.mgStar


17 18


15

16


2801 of t. Lamp Signal Image: Signal			
Image: Signal indication in the submitted (Please be note) Image: Signal indication in the submitted (Please be note) Image: Signal indication in the submitted (Please be note) Image: Signal indication in the submitted (Please be note) Image: Signal indication in the submitted (Please be note) Image: Signal indication in the submitted (Please be note) Image: Signal indication in the submitted (Please be note) Image: Signal indication in the submitted (Please be note) Image: Signal indication in the submitted (Please be note) Image: Signal indication in the submitted (Please be note) Image: Signal indication in the submitted (Please be note) Image: Signal indication in the submitted (Please be note) Image: Signal indication in the submitted (Please be note) Image: Signal indication in the submitted indit indit indication in the submitted indit indication	19		_
Image: Signal indication in the submitted (Please be note) Image: Signal indication in the submitted (Please be note) Image: Signal indication in the X:A COMPRESSOR A X:B COMPRESSOR B X:C COMPRESSOR C Note2: WIRE 1.5mm^2 BLACK Ammeter 2.5mm^2 BLACK Image: Signal		Note1 :	
X:B COMPRESSOR B X:C COMPRESSOR C Note2_: WIRE 1.5mm^2 BLACK Ammeter 2.5mm^2 BLACK Silicone wire SIMCO brand Lawy Signal Jameser Jameser Ammeter Ammeter <		X-A COMPRESSOR A	
X:C COMPRESSOR C Note2 :: WIRE 1.5mm^2 BLACK Ammeter 2.5mm^2 BLACK Ammeter 2.5mm^2 BLACK Silicone wire SIMCO brand Legend :: Lamp Sigual Solector switch Solector switch Ammeter Ammeter Solector switch Ammeter Ammeter <			Ц
Note2 :: WIRE 1.5mm^22 BLACK Ammeter 2.5mm^2 BLACK Silicone wire SIMCO brand Legend :: Lamp Sigual Belleton Selector switch Ammeter Selector switch Ammeter			
OT Image: Signal		X:C COMPRESSOR C	E
OT Image: Signal		Note2	
Animeter 2.5mm^2 BLACK Silicone wire SIMCO brand Image Signal Lange Signal Jamp Signal			Н
Silicone wire SIMCO brand Imp Signal			
Of t Lamp Signal Imposed to the second seco	7		F
OT Lamp Signal Image: Signal <td></td> <td>Silicone wire SIMCO brand</td> <td></td>		Silicone wire SIMCO brand	
OT Lamp Signal Image: Signal <td></td> <td></td> <td>Н</td>			Н
OT Lamp Signal Image: Signal <td></td> <td></td> <td></td>			
On Jump Signal John Signal </td <td></td> <td>Legend :</td> <td>6</td>		Legend :	6
2801 of t. Lamp Signal Image: Signal	on		
of t. Push Bottom Push Bottom Push Bottom Selector switch Push Bottom Ammeter Ammeter d cartificate shall be submitted. (Please be note t stage) Push Bottom d cartificate shall be submitted. (Please be note t stage) Push Bottom Manueter Push Bottom Push Bottom Push Bottom Pu			Н
of t. Push Bottom Push Bottom Push Bottom Selector switch Push Bottom Ammeter Ammeter d cartificate shall be submitted. (Please be note t stage) Push Bottom d cartificate shall be submitted. (Please be note t stage) Push Bottom Manueter Push Bottom Push Bottom Push Bottom Pu	een	Lamp Signal	
t. Push Bottom Selector switch Ammeter Ammete	of		н
Selector switch Ammeter Selector switch Ammeter Ammeter Ammeter Ammeter Ammeter Ammeter Ammeter Ammeter Ammeter Ammeter Ammeter Ammeter Ammeter Ammeter Ammeter Ammeter Ammeter Ammeter		Push Bottom	
Ammeter Ammeter Ammeter Ammeter Ammeter Ammeter Ammeter Ammeter Ammeter Ammeter Ammeter Ammeter Ammeter Ammeter Ammeter Ammeter Ammeter Ammeter Ammeter			Н
Ammeter Ammete		Selector switch	
Ammeter Ammete		· · · · · -	╢
d certificate shall be submitted. (Please be note t stage) Image: Construction of the submitted. (Please be note t stage) MFAGGRARIAN MEAGGR			ľ
d certificate shall be submitted. (Please be note t stage) Image: Construction of the submitted. (Please be note t stage) MFAGGRARIAN MEAGGR			Н
d certificate shall be submitted. (Please be note t stage) n MEAGGARRINE MASAGEORIAN INFAGGARRINA MARCEORIAN INFAGGARRINA MARCEORIAN INFAGGARRINA MARCEORIAN INFAGGARRINA MARCEORIAN INFAGGARRINA AMARCEORIAN INFAGGARRINA AMARCEORIAN INFAGRI		Ammeter	
MFAKHARIAN MSADEGHAN MERTSURFACE REV. DESCRIPTION BY MENTSURFACE MSADEGHAN MENTSURFACE MSADEGHAN METEROINAL AND ALL COPES OF THIS DRAWIN TOGETHER WITH THE COPINCINT THEREIN ARE THE SOLE PROPERTY OF N.I.S.O.C./ Q PETCONTRACTOR: PETROIRAN DEVELOPMENT COMPANY BINAK OILIFIELD DEVELOPMENT SURFACE WORK PACKAGES R T MCONSTRUCTION PERMITTED UNLESS DRAWING APPROVED APPROVED FOR CONSTRUCTION BY: T SHEET NO. REV. BUGET REF. LOCATION SIZE CLASS SERIAL NO. S -PY-0001 01 09 12 VQ 1 22 A0 <td></td> <td></td> <td>к</td>			к
MFAKHARIAN MSADEGHAN MERTSURFACE REV. DESCRIPTION BY MENTSURFACE MSADEGHAN MENTSURFACE MSADEGHAN METEROINAL AND ALL COPES OF THIS DRAWIN TOGETHER WITH THE COPINCINT THEREIN ARE THE SOLE PROPERTY OF N.I.S.O.C./ Q PETCONTRACTOR: PETROIRAN DEVELOPMENT COMPANY BINAK OILIFIELD DEVELOPMENT SURFACE WORK PACKAGES R T MCONSTRUCTION PERMITTED UNLESS DRAWING APPROVED APPROVED FOR CONSTRUCTION BY: T SHEET NO. REV. BUGET REF. LOCATION SIZE CLASS SERIAL NO. S -PY-0001 01 09 12 VQ 1 22 A0 <td></td> <td></td> <td></td>			
MFAKHARIAN MSADEGHAN MERTSURFACE REV. DESCRIPTION BY MENTSURFACE MSADEGHAN MENTSURFACE MSADEGHAN METEROINAL AND ALL COPES OF THIS DRAWIN TOGETHER WITH THE COPINCINT THEREIN ARE THE SOLE PROPERTY OF N.I.S.O.C./ Q PETCONTRACTOR: PETROIRAN DEVELOPMENT COMPANY BINAK OILIFIELD DEVELOPMENT SURFACE WORK PACKAGES R T MCONSTRUCTION PERMITTED UNLESS DRAWING APPROVED APPROVED FOR CONSTRUCTION BY: T SHEET NO. REV. BUGET REF. LOCATION SIZE CLASS SERIAL NO. S -PY-0001 01 09 12 VQ 1 22 A0 <td></td> <td></td> <td>Н</td>			Н
MFAKHARIAN MSADEGHAN MERTSURFACE REV. DESCRIPTION BY MENTSURFACE MSADEGHAN MENTSURFACE MSADEGHAN METEROINAL AND ALL COPES OF THIS DRAWIN TOGETHER WITH THE COPINCINT THEREIN ARE THE SOLE PROPERTY OF N.I.S.O.C./ Q PETCONTRACTOR: PETROIRAN DEVELOPMENT COMPANY BINAK OILIFIELD DEVELOPMENT SURFACE WORK PACKAGES R T MCONSTRUCTION PERMITTED UNLESS DRAWING APPROVED APPROVED FOR CONSTRUCTION BY: T SHEET NO. REV. BUGET REF. LOCATION SIZE CLASS SERIAL NO. S -PY-0001 01 09 12 VQ 1 22 A0 <td></td> <td></td> <td></td>			
MFAKHARIAN MSADEGHAN MERTSURFACE REV. DESCRIPTION BY MENTSURFACE MSADEGHAN MENTSURFACE MSADEGHAN METEROINAL AND ALL COPES OF THIS DRAWIN TOGETHER WITH THE COPINCINT THEREIN ARE THE SOLE PROPERTY OF N.I.S.O.C./ Q PETCONTRACTOR: PETROIRAN DEVELOPMENT COMPANY BINAK OILIFIELD DEVELOPMENT SURFACE WORK PACKAGES R T MCONSTRUCTION PERMITTED UNLESS DRAWING APPROVED APPROVED FOR CONSTRUCTION BY: T SHEET NO. REV. BUGET REF. LOCATION SIZE CLASS SERIAL NO. S -PY-0001 01 09 12 VQ 1 22 A0 <td></td> <td></td> <td>Ľ</td>			Ľ
MFAKHARIAN MSADEGHAN MERTSURFACE REV. DESCRIPTION BY MENTSURFACE MSADEGHAN MENTSURFACE MSADEGHAN METEROINAL AND ALL COPES OF THIS DRAWIN TOGETHER WITH THE COPINCINT THEREIN ARE THE SOLE PROPERTY OF N.I.S.O.C./ Q PETCONTRACTOR: PETROIRAN DEVELOPMENT COMPANY BINAK OILIFIELD DEVELOPMENT SURFACE WORK PACKAGES R T MCONSTRUCTION PERMITTED UNLESS DRAWING APPROVED APPROVED FOR CONSTRUCTION BY: T SHEET NO. REV. BUGET REF. LOCATION SIZE CLASS SERIAL NO. S -PY-0001 01 09 12 VQ 1 22 A0 <td></td> <td></td> <td></td>			
MFARMARIAN MSADEGHIAN MFARMARIAN MSADEGHIAN MFARMARIAN SFARMARZZOUR MFARMARIAN SFARMARZZOUR MERK DESCRIPTION DESCRIPTION BY DATE CHECKED CHE AMMOHSENI CHE APP. CHE APP. CHE APP. CHE APP. CHE APP. CHE APP. CHE AUT. CHE CHECKED CHE APP. CHE APP. CHE APP. CHE APP. ME CHECKED CHE VELOPMENT COMPANY DATE NO CONSTRUCTION PETOIRAN BY CHE DATE SHEET NO. REV. BURGET REF. LOCATION CHE CHE <		ted. (Please be note	П
MFAGHARIAN MSADEGHIAN MFAGHARIAN MSADEGHIAN MFAGHARIAN SFARAMAR2POUR REV. DESCRIPTION DESCRIPTION BY DATE CHECKED CHK APP. AUT. CHECKED CHK APP. MEROTSURFACE WORK PACKAGES FEDCO PETROIRAN DESCRIPTION DESCRIPTION CHECKED BY DATE SCALE DATE SCALE DATE CHECKED BY DATE NO CONSTRUCTION PERMITED UNLESS DRAWING APPROVED APPROVED FOR CONSTRUCTION BY: PP-0001 01 91 12 V02 1 19 20	it stage)		
MFARHARIAN M SADEGHIAN MFARHARIAN M SADEGHIAN MFARHARIAN SFARAAMAR2POUR MFARHARIAN SFARAAMAR2POUR CHK APP. AUT. CHECKED CHK APP. CHK APP. AUT. CHECKED SOF THIS DRWINT TOGETHER WITH THE COPRICINT THEREIN ARE THE SOLE PROPERTY OF N.I.S.O.C./ PETROIRAN DEVELOPMENT SURFACE WORK PACKAGES PETROIRAN DATE SHEET NO. REV. BUGET REF. LOCATION ISHEET NO. REV. BUGET REF. LOCATION SHEET NO. REV. BUGET REF. LOCATION SHEET NO. REV. BUGET REF. LOCATION SHEET NO. REV. BUGET REF. LOCATION S			M
MFARHARIAN M SADEGHIAN MFARHARIAN M SADEGHIAN MFARHARIAN SFARAAMAR2POUR MFARHARIAN SFARAAMAR2POUR CHK APP. AUT. CHECKED CHK APP. CHK APP. AUT. CHECKED SOF THIS DRWINT TOGETHER WITH THE COPRICINT THEREIN ARE THE SOLE PROPERTY OF N.I.S.O.C./ PETROIRAN DEVELOPMENT SURFACE WORK PACKAGES PETROIRAN DATE SHEET NO. REV. BUGET REF. LOCATION ISHEET NO. REV. BUGET REF. LOCATION SHEET NO. REV. BUGET REF. LOCATION SHEET NO. REV. BUGET REF. LOCATION SHEET NO. REV. BUGET REF. LOCATION S			
MFARHARIAN M SADEGHIAN MFARHARIAN M SADEGHIAN MFARHARIAN SFARAAMAR2POUR MFARHARIAN SFARAAMAR2POUR CHK APP. AUT. CHECKED CHK APP. CHK APP. AUT. CHECKED SOF THIS DRWINT TOGETHER WITH THE COPRICINT THEREIN ARE THE SOLE PROPERTY OF N.I.S.O.C./ PETROIRAN DEVELOPMENT SURFACE WORK PACKAGES PETROIRAN DATE SHEET NO. REV. BUGET REF. LOCATION ISHEET NO. REV. BUGET REF. LOCATION SHEET NO. REV. BUGET REF. LOCATION SHEET NO. REV. BUGET REF. LOCATION SHEET NO. REV. BUGET REF. LOCATION S			
MERGENERAL SFARMAMEPOUR REV. DESCRIPTION BY DATE CHE KED CHECKED CHECKED CHECKED CH. APP. AUT. od 3 - So od a wind 1 color and a wind od color and a wind a wind od color and a wind a wind to color and wi	1 1		p
MERGENERAL SFARMAMEPOUR REV. DESCRIPTION BY DATE CHE KED CHECKED CHECKED CHECKED CH. APP. AUT. od 3 - So od a wind 1 color and a wind od color and a wind a wind od color and a wind a wind to color and wi			$\left \right $
MEFAGUARIAN AMMOHSEN REV. DESCRIPTION CHECKED CHK APP. AUT. حال ہے جاتے ہے۔ CHECKED GENT SURFACE WORK PACKAGES THE ORIGNAL AND ALL COPIES OF THIS PORTIN TOCETHER WITH THE COPRICINT THEREIN ARE THE SOLE PROPERTY OF N.I.S.O.C./ FIELDS THE ORIGNAL AND ALL COPIES OF THIS PORTHER WITH THE COPRICINT THEREIN ARE THE SOLE PROPERTY OF N.I.S.O.C./ FIELDS THE ORIGNAL AND ALL COPIES OF THIS PORTHER WITH THE COPRICINT THEREIN ARE THE SOLE PROPERTY OF N.I.S.O.C./ FIELDS PETCOITRACTOR: PETROIRAN DEVELOPMENT COMPANY DATE SCALE DRAWING BY CHECKED BY DATE SCALE DRAWING BY CHECKED BY T APPROVED FOR CONSTRUCTION BY: SECALE SERIAL NO. -PY-0001 01 09 12 VO2 21 22 A0			1
CHK. APP. AUT. MENT SURFACE WORK PACKAGES حال على على على على على على على على على عل		REV. DESCRIPTION	$\left \right $
THE COPYRICHT THEREN ARE THE SOLE PROPERTY OF N.I.S.O.C./ FIELDS PETROIRAN DEVELOPMENT COMPANY T T T T SHEET NO. REV. BUDGET REF. LOCATION SIZE CLASS SERIAL NO. S PP-0001 01 09 12 V2 C PC PC PC PC PC PC PC PC PC		۵. هربیمه باونج ییخ نطق قطانه علیه نگارش به قلیخهم سیبتق قرح و شقف زی اهضین فلک و ایمی م	
PD CONTRACTOR: PETROIRAN DEVELOPMENT COMPANY T SHEET NO. REV. BUDGET REF. LOCATION SIZE CLASS SERIAL NO. PP-0001 01 09 12 V02 SHEET NO. REV. BUDGET REF. LOCATION SIZE CLASS SERIAL NO. PY-0001 01 09 12 V02 S	MENT SURFACE WORK PACKAGES	THE COPYRIGHT THEREIN ARE THE SOLE PROPERTY OF	
PEDCO PETROIRAN DEVELOPMENT COMPANY DATE SCALE DRAWING BY CHECKED BY NO CONSTRUCTION PERMITTED UNLESS DRAWING APPROVED FOR CONSTRUCTION BY: SHEET NO. REV. BUDGET REF. LOCATION SIZE CLASS SERIAL NO. S PP-0001 01 09 12 V02 0 0 0 0 0 0 0 0 0 0 0 0 0 0 0 0 0		N.I.S.O.C./ FIELDS	╢
DEVELOPMENT COMPANY DATE SCALE DRAWING BY CHECKED BY 7T NO CONSTRUCTION PERMITTED UNLESS DRAWING APPROVED APPROVED FOR CONSTRUCTION BY:		BINAK OILFIELD DEVELOPMENT SURFACE WORK PACKAGES	
PEDCO NO CONSTRUCTION PERMITTED UNLESS DRAWING APPROVED JT APPROVED FOR CONSTRUCTION BY:	O DEVELOPMENT		R
JT APPROVED FOR CONSTRUCTION BY: SHEET NO. REV. BUDGET REF. LOCATION SIZE CLASS SERIAL NO. -PY-0001 01 0P 12 V02	PEDCO COMPANY	DATE SCALE DRAWING BY CHECKED BY	$\left \right $
JT APPROVED FOR CONSTRUCTION BY: SHEET NO. REV. BUDGET REF. LOCATION SIZE CLASS SERIAL NO. -PY-0001 01 0P 12 V02		NO CONSTRUCTION PERMITTED UNLESS DRAWING APPROVED	╢
-PY-0001 01 0F 12 V02 S		APPROVED FOR CONSTRUCTION BY:	1
		BUDGET REF. LOCATION SIZE CLASS SERIAL NO.	-s
		20 21 22 A0 Software Autocod File No BK-GCS-HY-120-IN-PY-0001-VI	 02.d•

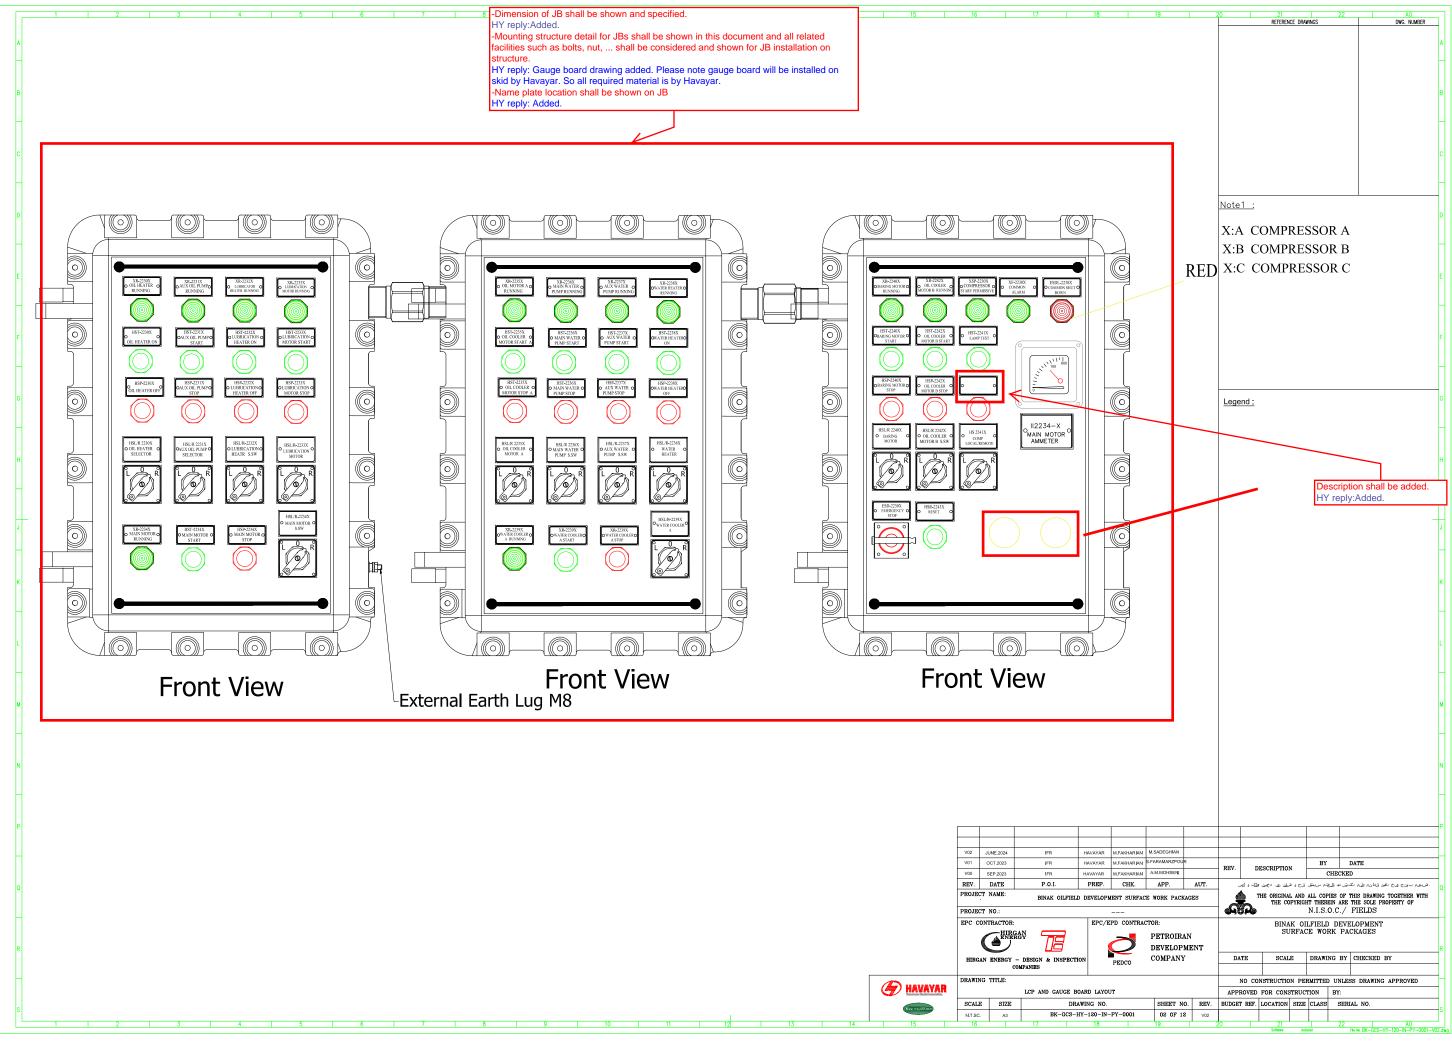

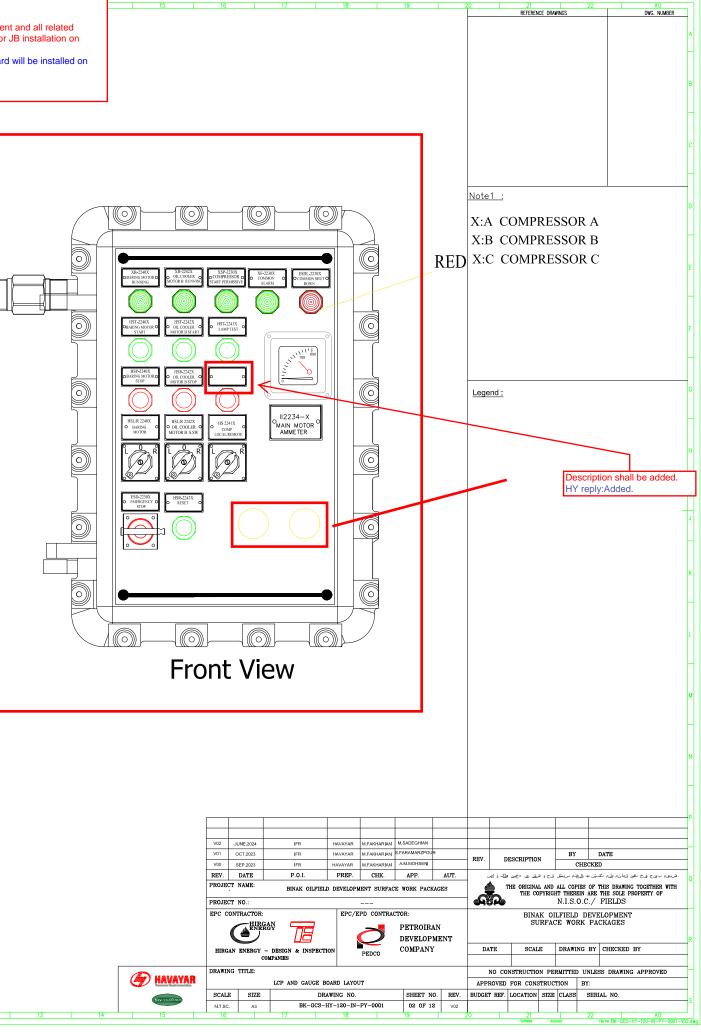


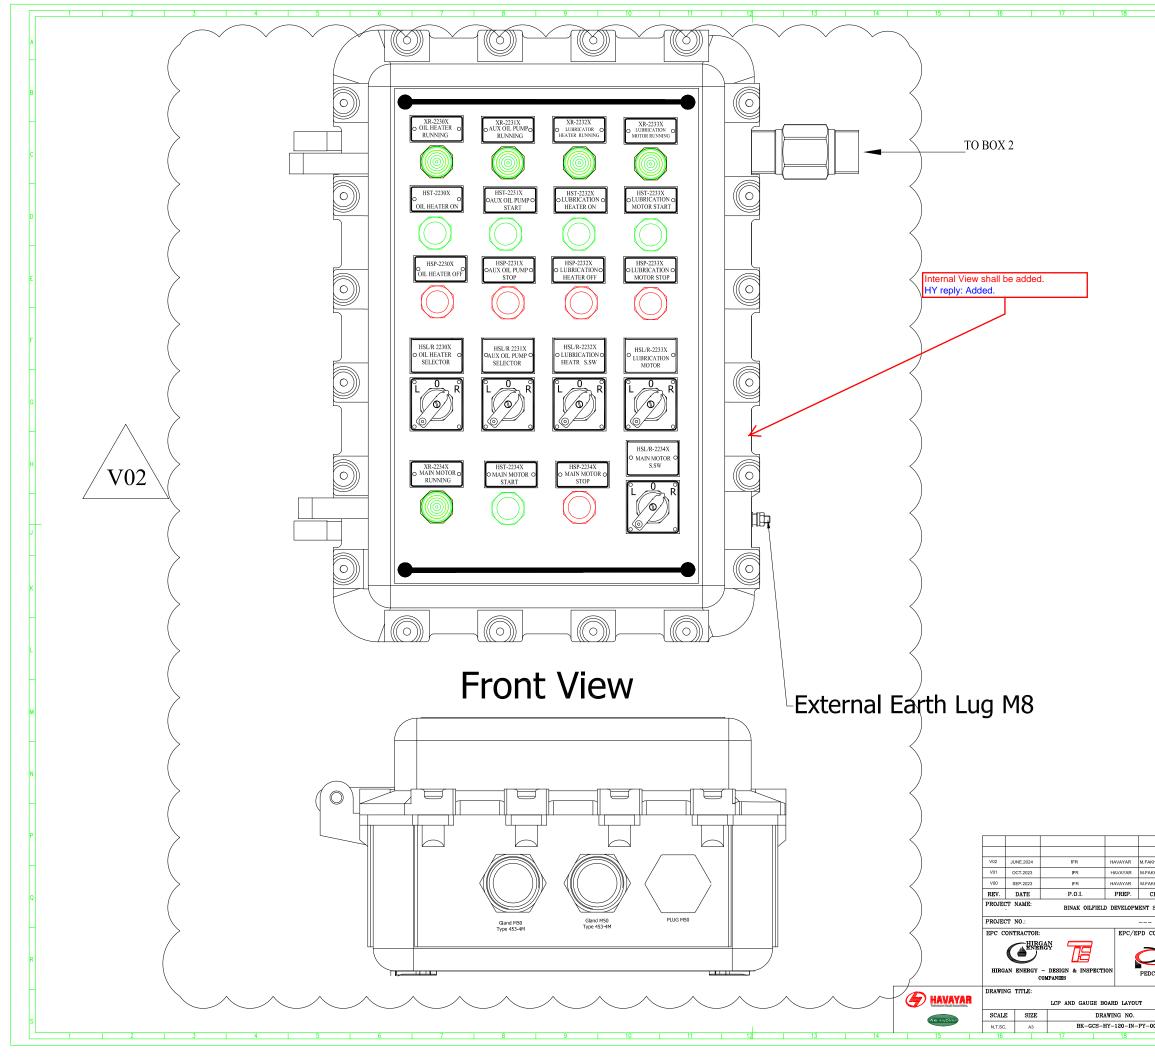


	19		20		REFEREN	NCE DRAV	WINGS	- 22		DWG. NUMBER	
											Â
											Π
											В
											Ň
											Ц
				4							-
			Note	<u>: :</u>							D
			X:A	A C	OMP	RE	SSO	R A			
			X:F	в с	OMP	RE:	sso	RВ			Н
					OMP						
			21.0		own	πĽ	550	кс			E
											Н
											F
			1.0	nd ·							G
			Lege	<u>. nu :</u>							
											H
											н
											Н
										-	J
											Π
											K
											Ĩ
											Н
											L
											H
											м
											Н
											Ν
											P
				-				+			$\left\{ \right\}$
HARIAN	M.SADEGHIAN								D.4.0073		Н
HARIAN	S.FARAMARZPOU A.M.MOHSENI		REV.	D	ESCRIPTIO	N	BY	HECKE	DATE D		
HK.	APP.	AUT.					چم سيتى	رش به، ول	خ نفی وطنم علیم نگ		Q
SURFAC	E WORK PACE	AGES			THE ORIGINA	AL AND OPYRIGI	ALL COP	LES OF	THIS DRAWING TO THE SOLE PROPE FIFLDS	GETHER WITH RTY OF	
ONTRAG	CTOR:			949	BIN	AK OT			FIELDS CLOPMENT		╢
-	PETROIR.	AN							CKAGES		
2	DEVELOP COMPANY			TE	SCAL	LR	DRAWI	IG PV	CHECKED BY		R
20	COMPAN			.110	SCA		JRAWI	10 DI	CHECKED BY		
			-						SS DRAWING AF	PROVED	H
	SHEET N	0. REV.	APP: BUDGE		FOR CON	1	TION CLASS	BY: SER	IAL NO.		$\left \right $
001	03 OF 1									10	S
1	19		20		21 Software		coad	22	File No BK-GCS-HY-1	AU	

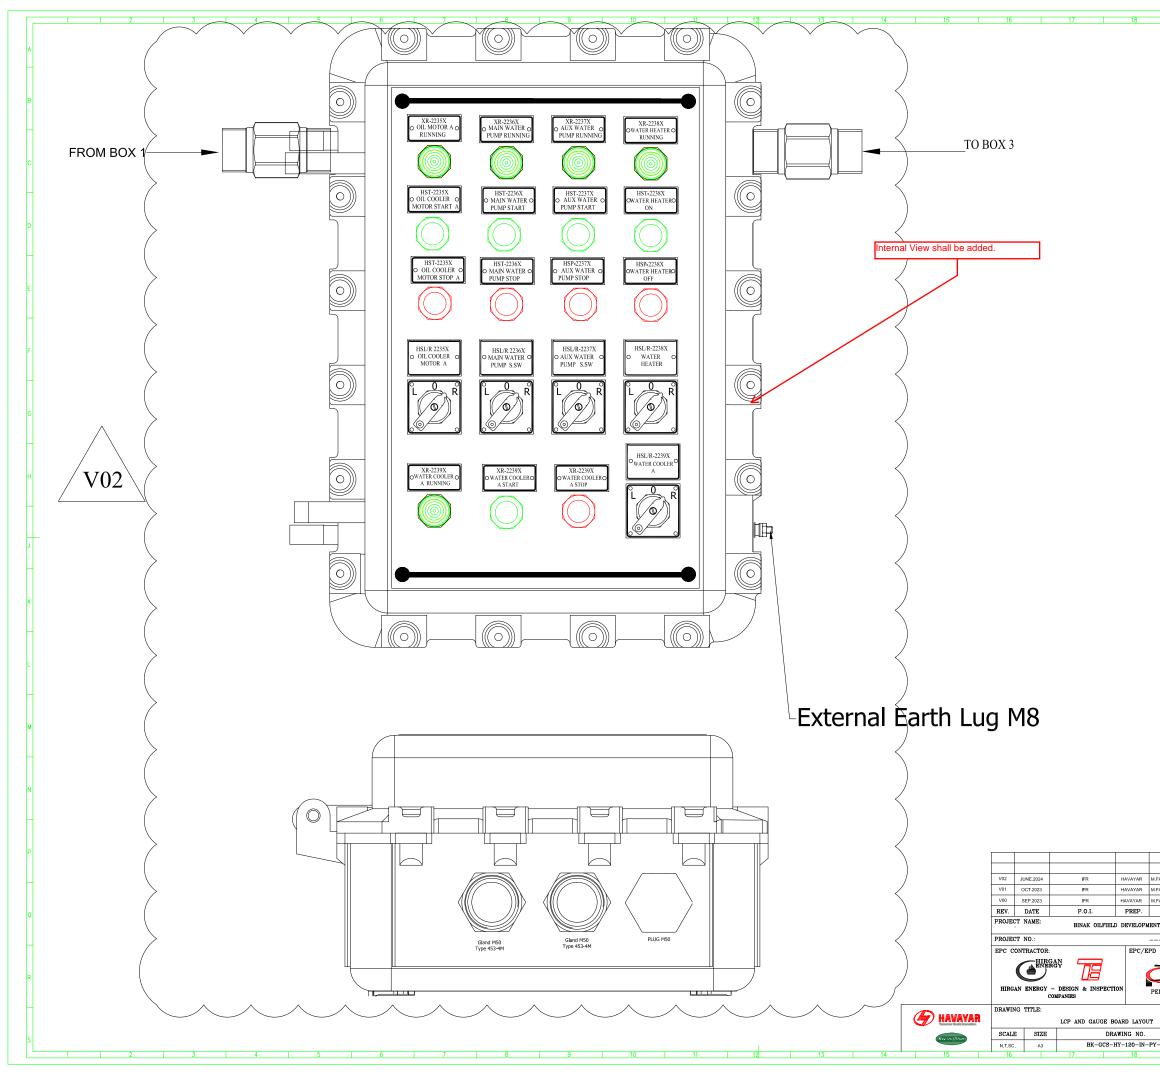


19	20 21 22 A0 REFERENCE DRAWINGS DWG. NUMBER
	Note1 :
	X:A COMPRESSOR A
	X:B COMPRESSOR B
	X:C COMPRESSOR C
	A.C. COMI RESSOR C
	Legend :
AKHARIAN M SADEGHAN	
	REV DESCRIPTION BY DATE
AKHARIAN S.FARAMARZPOUR AKHARIAN A.M.MOHSENI	REV. DESCRIPTION CHECKED
AKHARIAN S.FARAMARZPOUR AKHARIAN A.M.MOHSENI CHK. APP. AUT.	REV. DESCRIPTION CHECKED
AKHARIAN S.FARAMARZPOUR AKHARIAN A.M.MOHSENI CHK. APP. AUT.	REV. DESCRIPTION CHECKED حارث علی محرف محرف علی محرف محرف علی محرف محرف علی محرف محرف علی محرف عحوف محوف محرف علی محرف علی محرف علی محرف علی محرف علی محرف علی مح
AKHARIAN SFARAMARZPOUR AKHARIAN AMMOHSENI CHK. APP. AUT. Y SURFACE WORK PACKAGES	REV. DESCRIPTION CHECKED العالي المحالي محالي المحالي محالي المحالي المحالي محالي المحالي المحالي المحال
AKHARIAN SFARAMARZPOUR AKHARIAN AMMOHSENI CHK. APP. AUT. I SURFACE WORK PACKAGES	REV. DESCRIPTION CHECKED حارث علی محرف محرف علی محرف محرف علی محرف محرف علی محرف محرف علی محرف عحوف محوف محرف علی محرف علی محرف علی محرف علی محرف علی محرف علی مح
AKHARIAN SFARAMARZPOUR AKHARIAN A.M.MOHSENI CHL. APP. AUT. I SURPACE WORK PACKAGES - CONTRACTOR:	REV. DESCRIPTION CHECKED حال من اللہ اللہ اللہ اللہ اللہ اللہ اللہ الل
AKHARIAN É-FARAMARZPOUR AKHARIAN A.M.MOHSENI CHK. APP. AUT. T SURFACE WORK PACKAGES - CONTRACTOR: PETROIRAN	REV. DESCRIPTION CHECKED حال من اللہ اللہ اللہ اللہ اللہ اللہ اللہ الل
AKHARIAN É-FARAMARZPOUR AKHARIAN AMMOHSENI CHK. APP. AUT. T SURFACE WORK PACKAGES - CONTRACTOR: PETROIRAN DEVELOPMENT DEVELOPMENT	REV. DESCRIPTION CHECKED العلي المحالي المحالي الحالي ال
AKHARIAN É-FARAMARZPOUR AKHARIAN AMMOHSENI CHK. APP. AUT. T SURFACE WORK PACKAGES - CONTRACTOR: PETROIRAN DEVELOPMENT DEVELOPMENT	REV. DESCRIPTION CHECKED المحالي مع المحالي ا
ARHARIAN FARAMARZPOUR ARHARIAN AMMOHSENI CHK. APP. AUT. ' SURFACE WORK PACKAGES - CONTRACTOR: DCO. PETROIRAN DEVELOPMENT COMPANY SHEET NO. REV.	REV. DESCRIPTION CHECKED رفال مل الحري الح
NEHARIAN EFARAMARZPOUR NEHARIAN AMMONSEN CHK APP. AUT. SURPACE WORK PACKAGES - CONTRACTOR: PETROIRAN DEVELOPMENT COMPANY	REV. DESCRIPTION CHECKED المالي الم

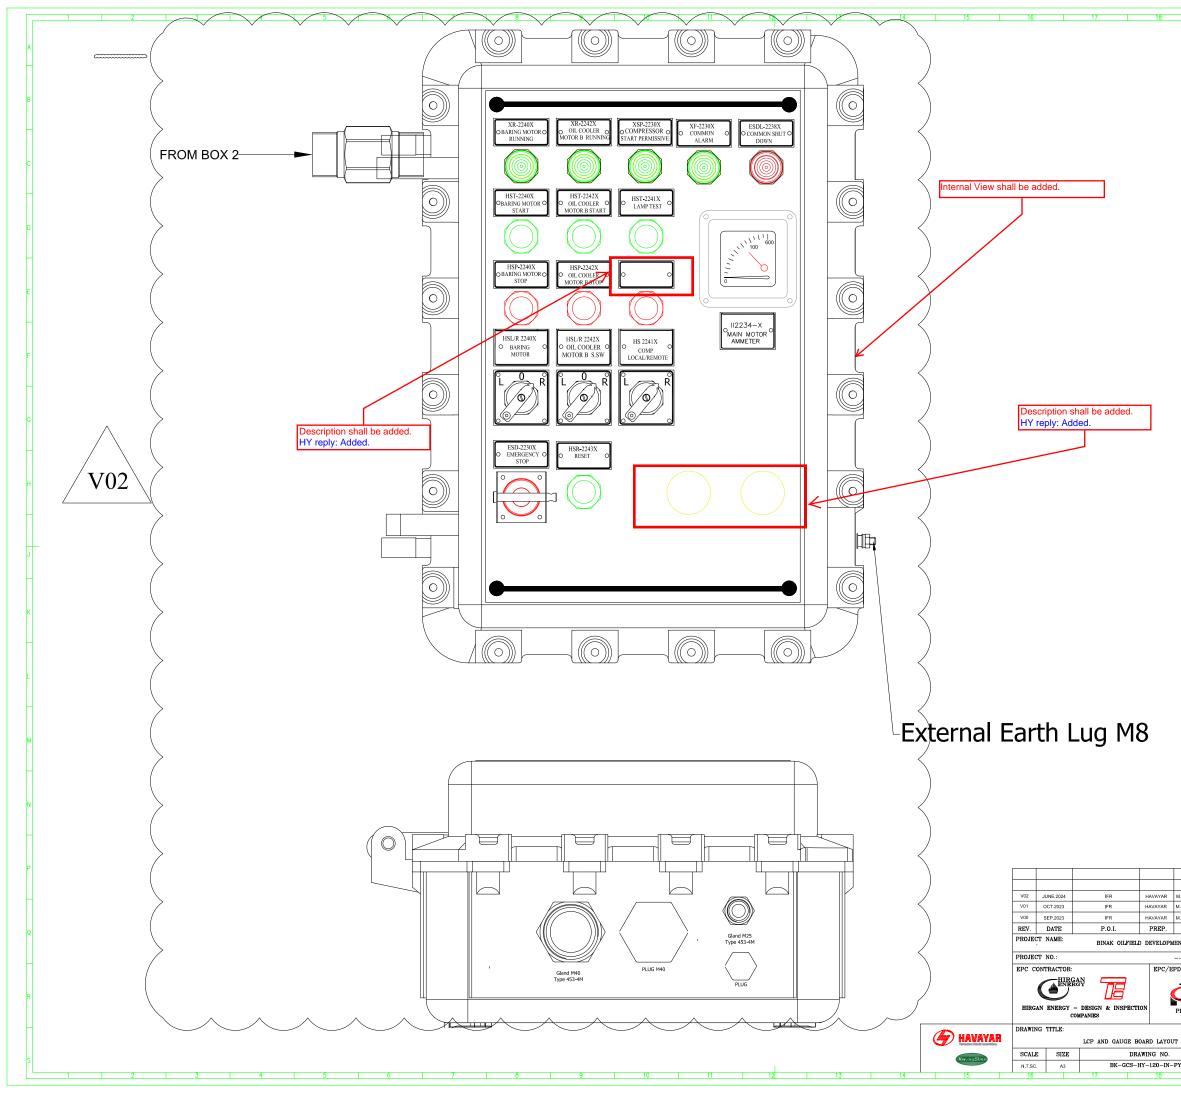



					_
19 2	20	21 REFERENCE DRAW	2: INGS	2 AO DWG. NUMBER	1
					A
					ľ
					П
					В
					Н
					С
					Η
	Note1	•			
	140101	<u>.</u>			D
	X:A	COMPRES	SOR A	A	
	x∙B	COMPRES	SOR	R	Н
	X:C	COMPRES	SSOR	C	Е
					Н
					F
					- G
	Leger	<u>nd :</u>			ľ
					н
				-	J
					Н
					к
					Н
					L
					Н
					м
					Н
					N
					Н
					P
A.FAKHARIAN M.SADEGHIAN			pv		╢
1.FAKHARIAN S.FARAMARZPOUR 1.FAKHARIAN A.M.MOHSENI	REV.	DESCRIPTION	BY CHECI	DATE	$\left\ \right\ $
CHK. APP. AUT.	ي م		ب وليخم سينق	. هربیم باونج فاخ نقق قطانم علیم نکارش	Q
NT SURFACE WORK PACKAGES		THE COPYRICH	T THEREIN AL	F THIS DRAWING TOGETHER WITH RE THE SOLE PROPERTY OF	
 D CONTRACTOR:	ల ార్ల			/ FIELDS	╢
PETROIRAN			FIELD DE E WORK F	VELOPMENT PACKAGES	
DEVELOPMENT				1	R
COMPANY	DAT	E SCALE	DRAWING B	Y CHECKED BY	$\left \right $
	N	0 CONSTRUCTION PER	MITTED UNI	LESS DRAWING APPROVED	╢
	APPR	OVED FOR CONSTRUCT	ION BY:		
SHEET NO. REV. Y-0001 05 OF 12 V02	BUDGET	REF. LOCATION SIZE	CLASS SI	ERIAL NO.	-s
	0	21 Software Autor	2	2 A0 File No BK-GCS-HY-120-IN-PY-0001-W	

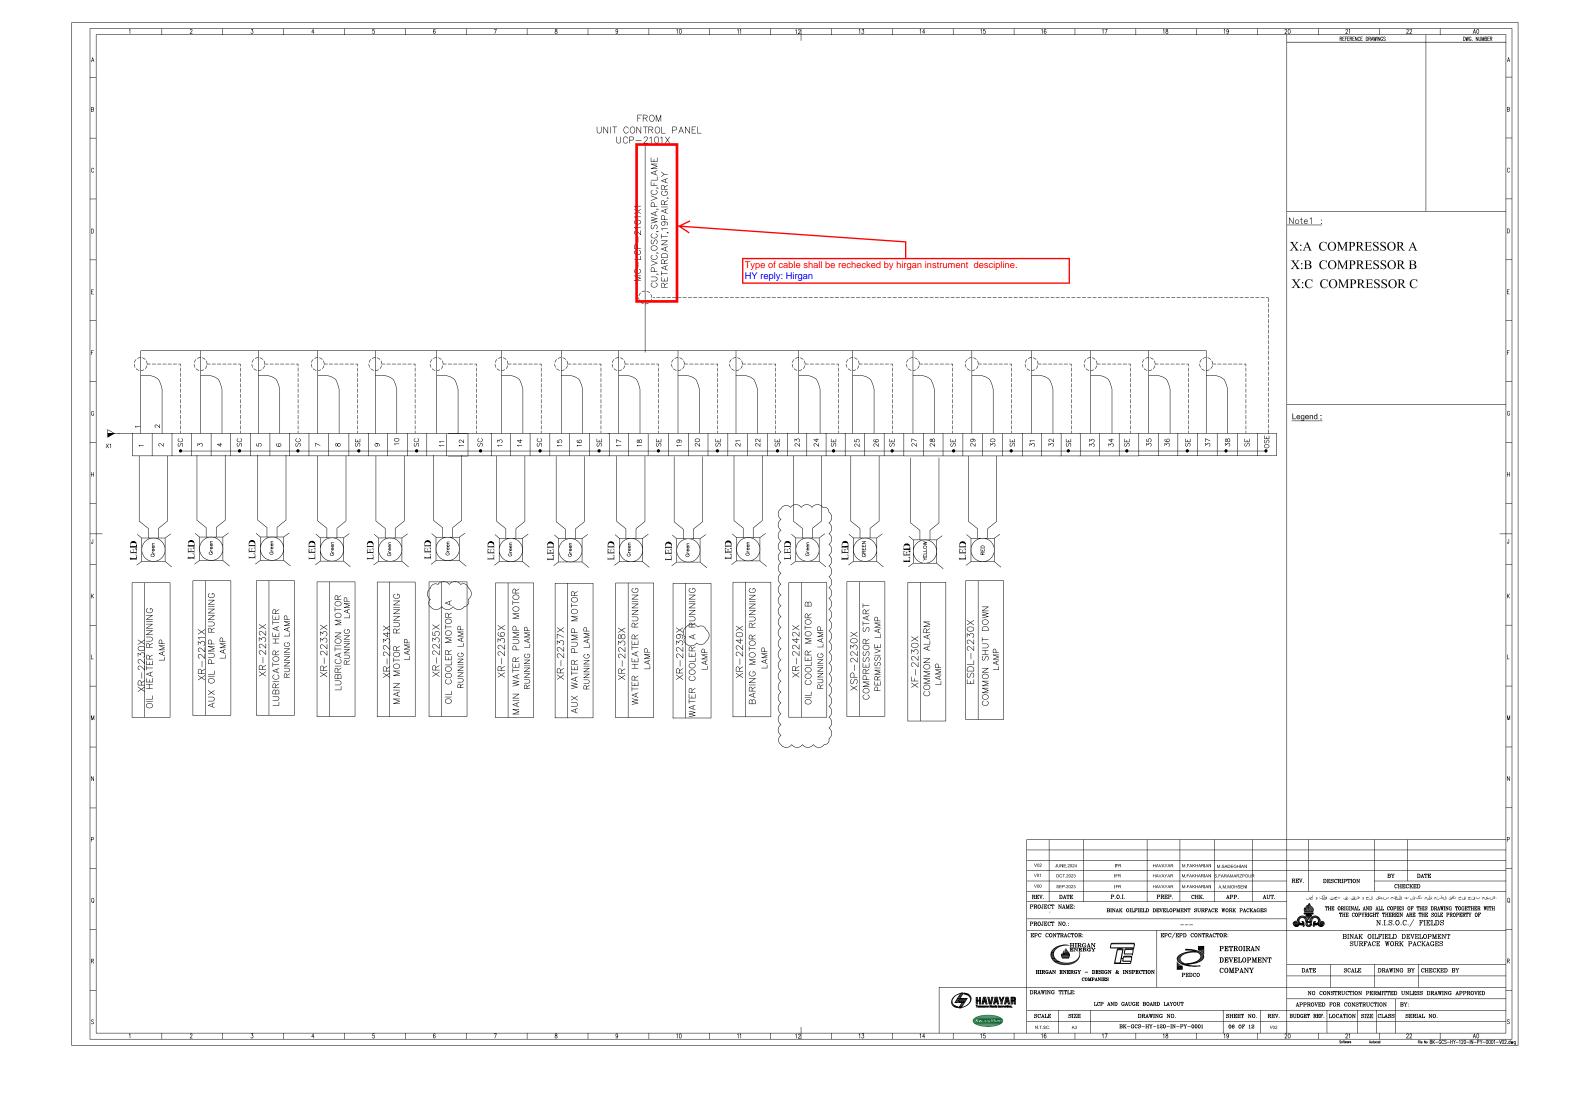

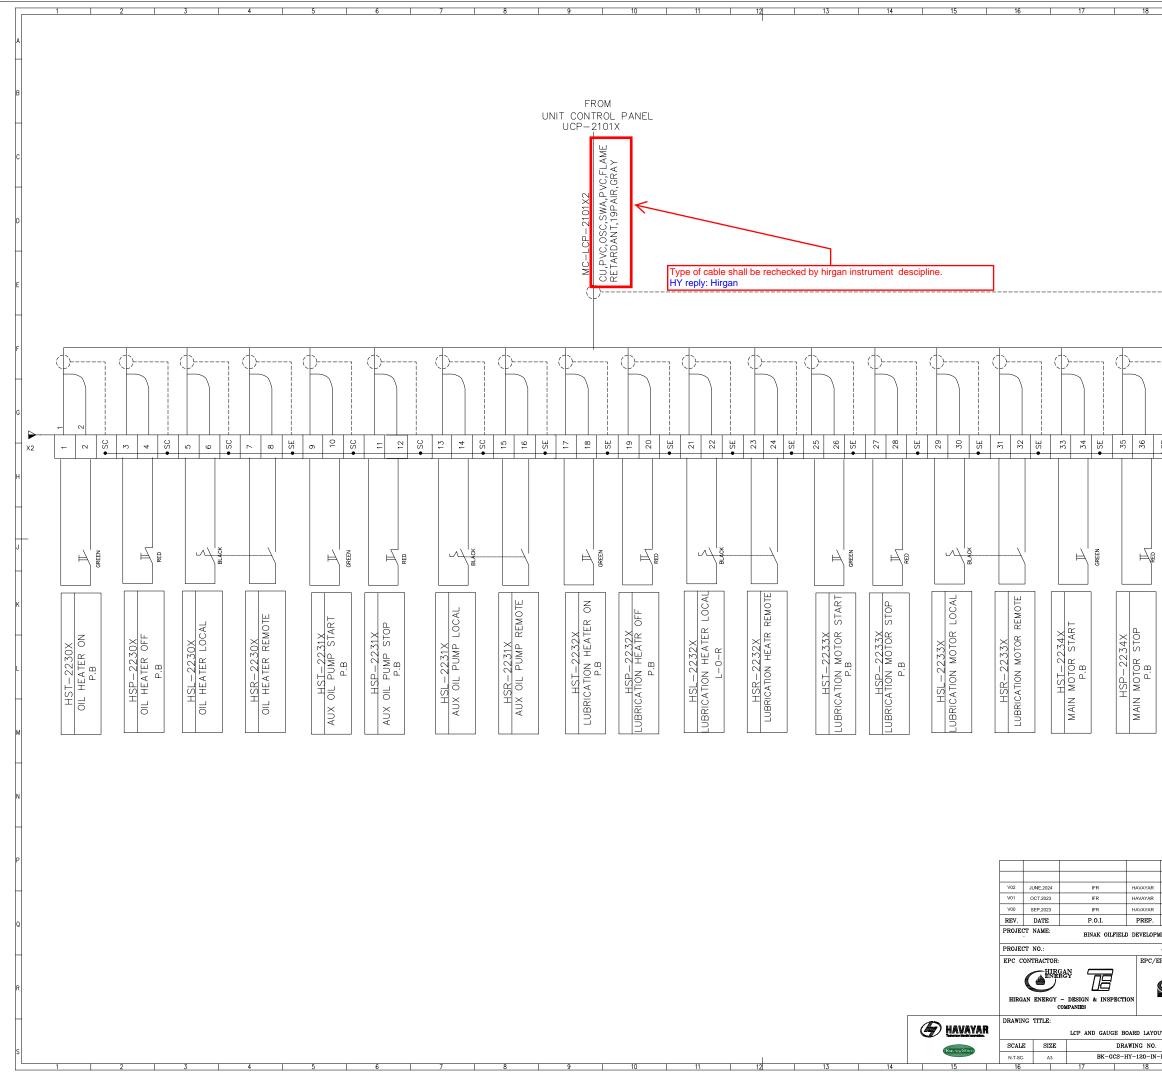


19	20 21 22 A0 REFERENCE DRAWINGS DWG. NUMBER
	REFERENCE UKAWINGS UWG. NUMBER
	Note1 :
	X:A COMPRESSOR A
	X:B COMPRESSOR B
	X:C COMPRESSOR C
j	
-ı Фı	
	Legend :
38 - 33 - 37 - 38 - 38 - 38 - 38 - 38 -	
• • •	
	-
M-FAKHARIAN M-SADEGHAN M-FAKHARIAN S-FARAMARZPOUR	
M.FAKHARIAN S.FARAMARZPOUR M.FAKHARIAN A.M.MOHSENI	REV. DESCRIPTION CHECKED
M.FAKHARIAN S.FARAMARZPOUR M.FAKHARIAN A.M.MOHSENI CHK. APP. AUT.	REV. DESCRIPTION CHECKED بالی کی این این این این این این این این این ای
M.FAKHARIAN S.FARAMARZPOUR M.FAKHARIAN A.M.MOHSENI CHK. APP. AUT.	REV. DESCRIPTION CHECKED
M.FAKHARIAN S.FARAMARZPOUR M.FAKHARIAN A.M.MOHSENI CHK. APP. AUT. MENT SURFACE WORK PACKAGES	REV. DESCRIPTION CHECKED حال علی اللہ اللہ اللہ اللہ اللہ اللہ اللہ ال
MFAGHARIAN SFARAMARZPOLK MFAGHARIAN AMMOHSENI CHK. APP. AUT. AUT. LENT SURFACE WORK PACKAGES PD CONTRACTOR: PETROIRAN	REV. DESCRIPTION CHECKED راب الحقي من الحقي الحقي المثل الحقي الحق المثل الحقي الحق
M FAGUARIAN S FARMAMERZPOLK M FAKHARIAN AM MCHSENI CHK. APP. AUT. MENT SURPACE WORK PACKAGES PD CONTRACTOR: PETROIRAN DEVELOPMENT COMPANY	REV. DESCRIPTION CHECKED نظی می دون علی می دون علی می دون می دون می دون می موند. می دون علی می دون می موند. THE ORIGINAL AND ALL COPIES OF THIS DRAWING TOCETHER WITH THE COPYRIGHT THEREMENA RE THE SOLE PROPERTY OF N.I.S.O.C./ FIELDS BINAK OILFIELD DEVELOPMENT SURFACE WORK PACKAGES
MFAGHARIAN SFARAMARZPOLK MFAGHARIAN AMMOHSENI CHK. APP. AUT. AUT. LENT SURFACE WORK PACKAGES PD CONTRACTOR: PETROIRAN	REV. DESCRIPTION CHECKED حال علی اللہ اللہ اللہ اللہ اللہ اللہ اللہ ال
MERAGUARIAN SEARAMARZPOLIK MERAKUARIAN A.M.MOUSENI CHK. APP. AUT. AUT. SURFACE WORK PACKAGES SPD CONTRACTOR: PETROIRAN DEVELOPMENT COMPANY	REV. DESCRIPTION CHECKED روایی از
MFAGHARIAN SFARAMARZPOUR MFARHARIAN AMMCHSENI CHK. APP. AUT. AUT. SURFACE WORK PACKAGES SPD CONTRACTOR: PEDCONTRACTOR: PETROIRAN DEVELOPMENT COMPANY	REV. DESCRIPTION CHECKED روابی این این این این این این این این این ای
MERAGUARIAN SEARAMARZPOLIK MERAKUARIAN A.M.MOUSENI CHK. APP. AUT. AUT. SURFACE WORK PACKAGES SPD CONTRACTOR: PETROIRAN DEVELOPMENT COMPANY	REV. DESCRIPTION CHECKED روابی این این این این این این این این این ای

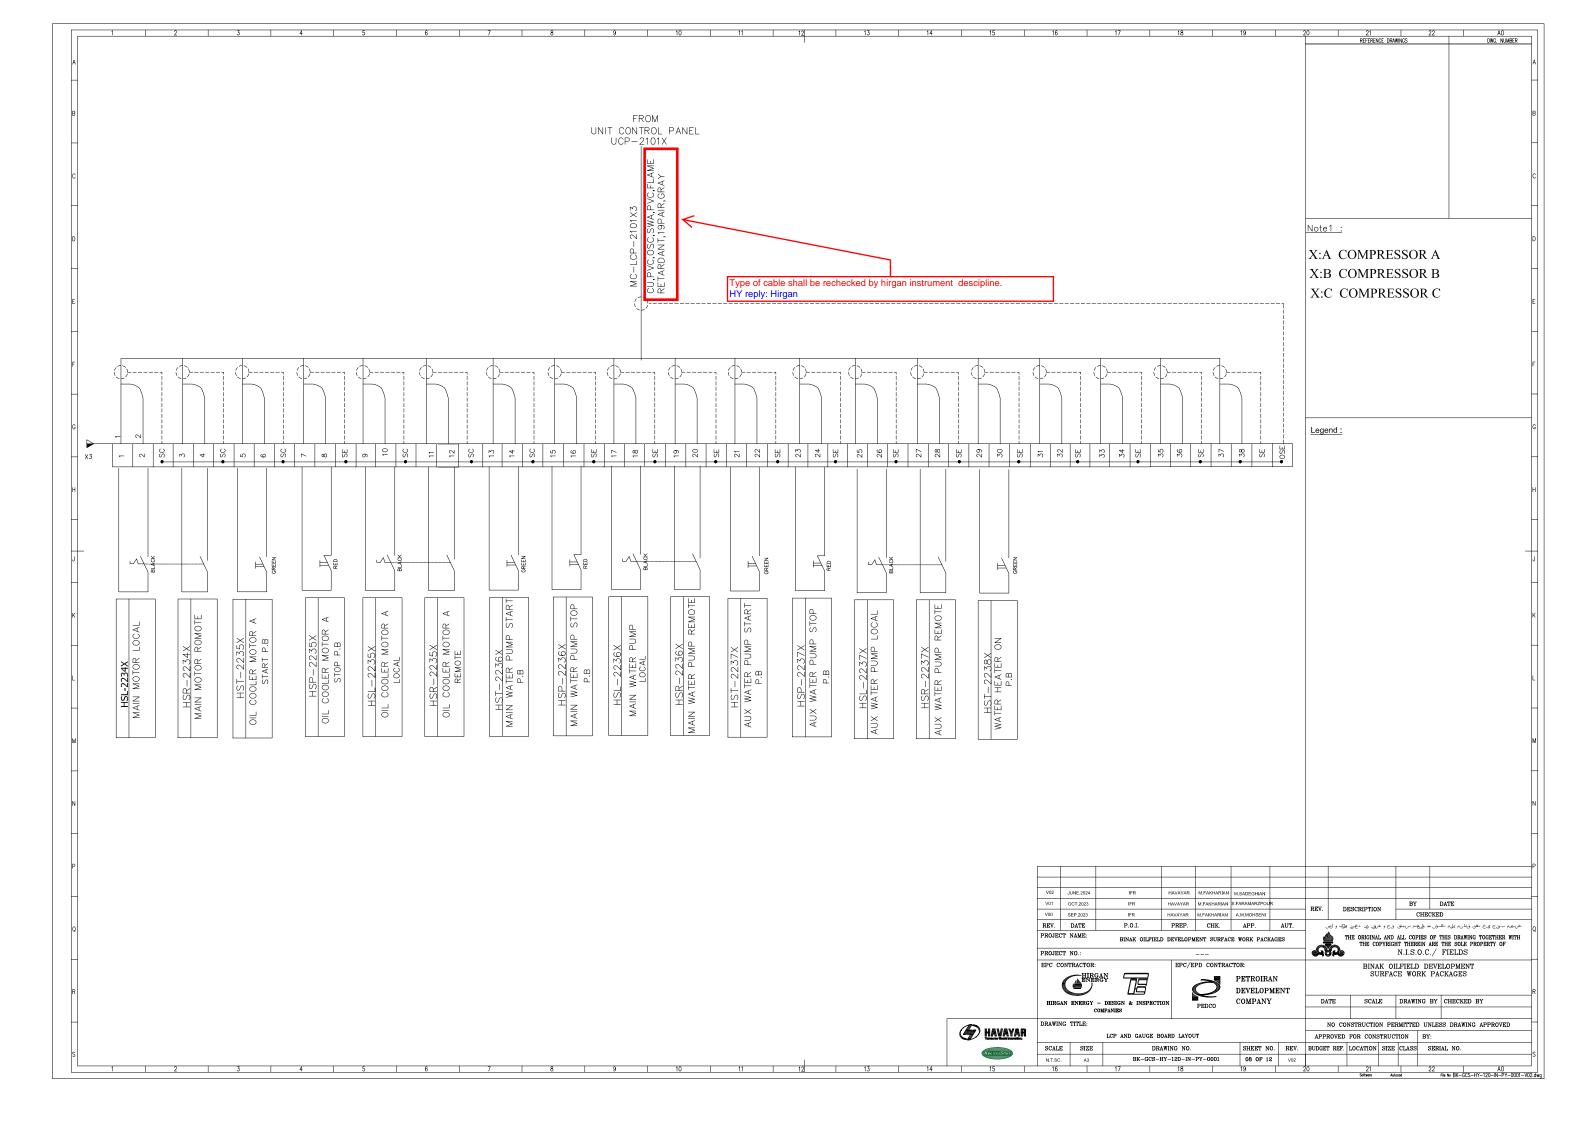


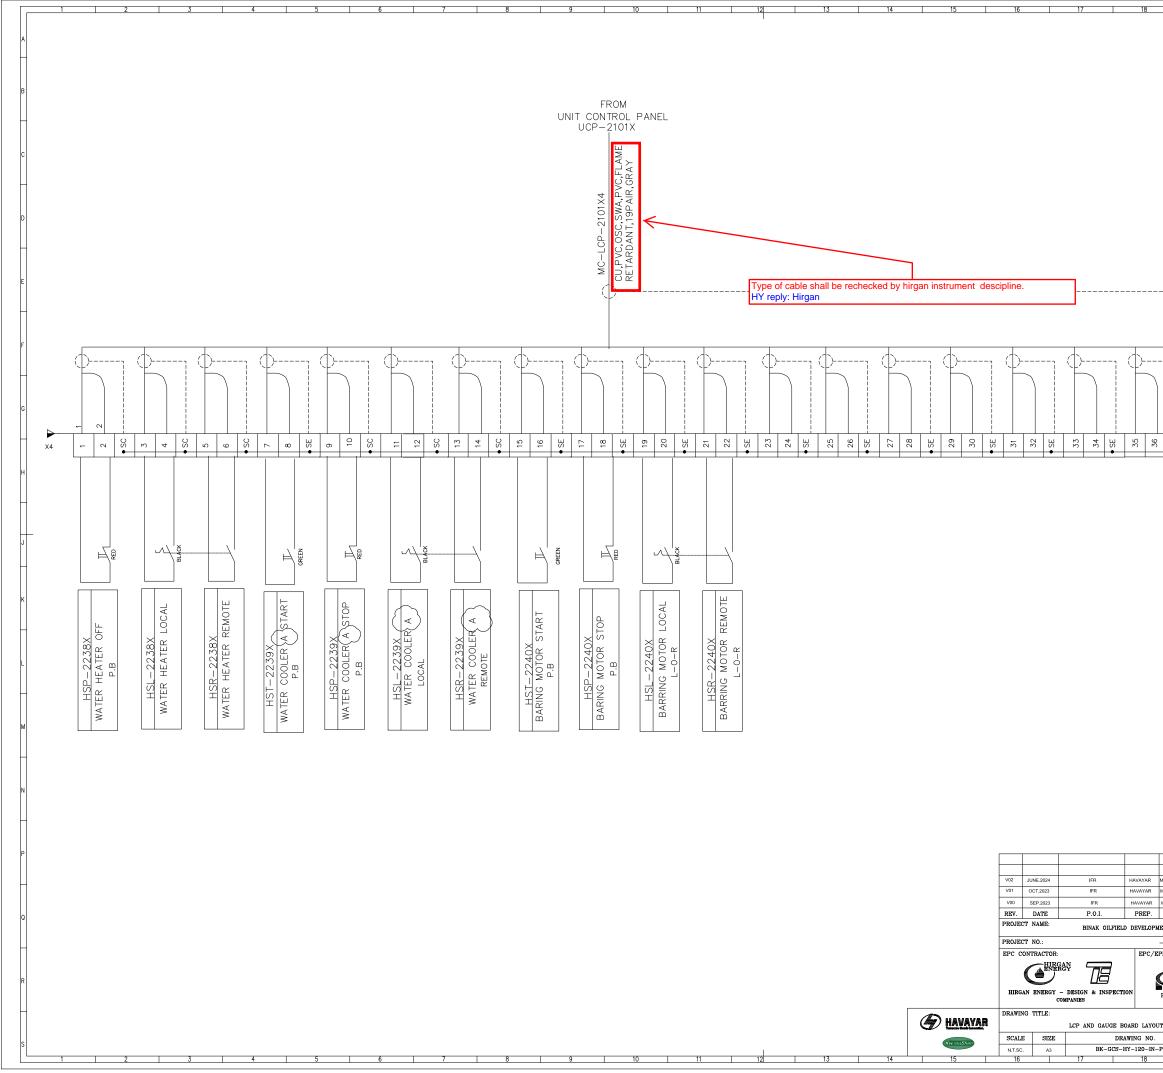

	19	,	-		0		21				22		A)	_
1	15	,		2		1	REFE	RENCE DRA	WINGS	2		- 1	DWG. N) Number	
															A
															Н
															в
															Ħ
															С
															Ц
					Note	1.									-
					note	<u> </u>									D
					X:A	0	COM	PRE	SSO	R	А				
					X:E	8 0	COM	PRE	SSO	R	В				Н
					X:0	C	COM	PRE	SSO	R	С				
				·1											E
															Ц
	1														F
, ()		7												
)	1												H
					Lege	<u>nd :</u>									G
			j D2	Т <u>щ</u>											Ц
- SE)ç	38	Я	• OSE											
															н
															H
															1
															к
															H
															L
															Π
															м
															N
															H
															P
															- '
M.FAKHARIAN		DEGHIAN	P									,			\exists
M.FAKHARIAN		AMARZPOU MOHSENI	Ê		REV.	1	DESCRIPT	ION	BY	HEC	DATE CKED	, 			
CHK.		APP.		AUT.								على قطنم وا DRAWING			Q
IENT SURFAC	r:₩O	RK PACK	AG]	ය	G	R	THE	COPYRIG	HT THERI N.I.S.	SIN A	ARE THE	DRAWING SOLE PRO	PERTY C	F F	
PD CONTRAC						. •		NAK OI SURFAG	ILFIELD	DI	EVELOF	PMENT			+
\sim		TROIRA		NT				JURI A	ов WUI	*17	I AUKA	GLID			R
PEDCO		MPANY			DA	TE	so	ALE	DRAWI	NG	BY CH	ECKED B	Y		- r
					1	NO CO	ONSTRUC	TION PR	RMITTER	UN	NLESS D	RAWING	APPROV	ED	-
T					APPI	ROVED	FOR CO	NSTRUC	TION	BY	ſ:				
PY-0001	_	SHEET N 09 OF 1:	_	REV .	BUDGET	REF	LOCATIO	ON SIZE	CLASS	s	SERIAL 1	NO.			_s
	19				0		21 Softwar	• •	tocad	2	22 File No	BK-GCS-HY	AI) PY-0001-'	

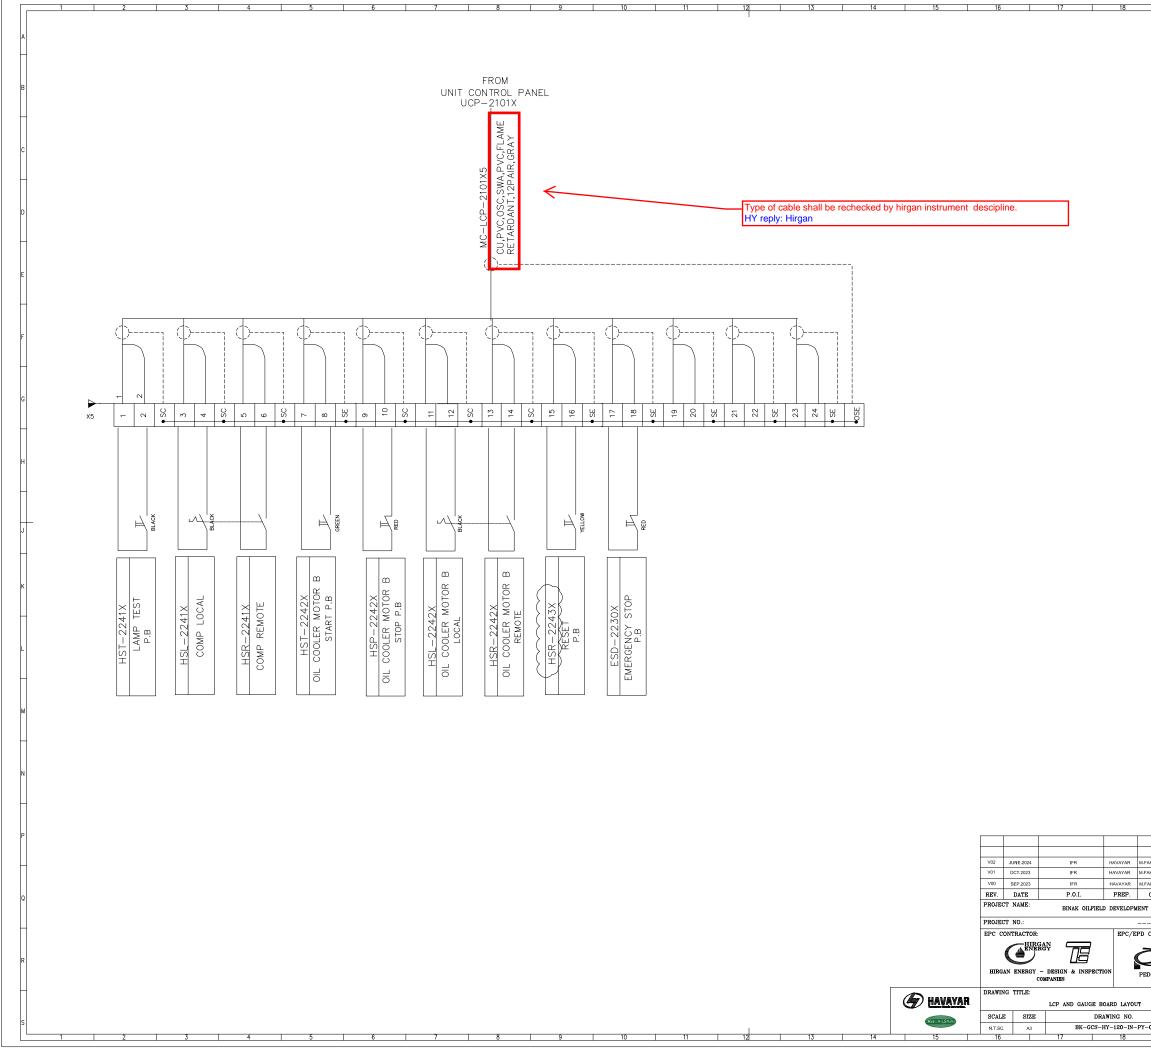

	19	2	20		2	1 (Rence dra)	MNCS	22		0	AO WG. NUMBER		
					NET E						NO. NOMBER	,	4
												E	3
												C	
												-	
			Note	<u>1 :</u>								C	
						PRE							
						PRE: PRE							
			Δ.			IKL	550	in c				E	
												F	
			Lege	<u>nd :</u>								C	9
												-	
												ŀ	4
													I
												٢	¢
												l	•
												ŀ	
												M	4
												1	"
												ŀ	
												F	
	I.SADEGHIAN	3					BY		DATE				
	A.M.MOHSENI APP.	AUT.	REV.		ESCRIP'I		(CHECKE	D	ىخ ىفن ق	يى بونچ :	<i>.</i>	
	WORK PACK					INAL AND COPYRIGI	ALL COP HT THERI	IES OF T		ING TOG	ETHER WIT TY OF		*
CONTRACT	or: PETROIRA	N			BI	NAK OI	LFIELD	DEVE	CKAGES	T		+	
2	DEVELOPM COMPANY	IENT	DA	TE	s	CALE	DRAWI	NG BY	CHECKE	D BY		F	
DCO			1	NO CO	NSTRUC	TION PE			SS DRAWI		ROVED		
	SHEET NO	-	APPI BUDGET		FOR CO	ONSTRUC	TION CLASS	BY: SERI	IAL NO.				
-0001	10 OF 12 19		0		2' Softwar	1 re Aub	0001	22	File No BK-GC	S-HY-120	A0 I-IN-PY-000		

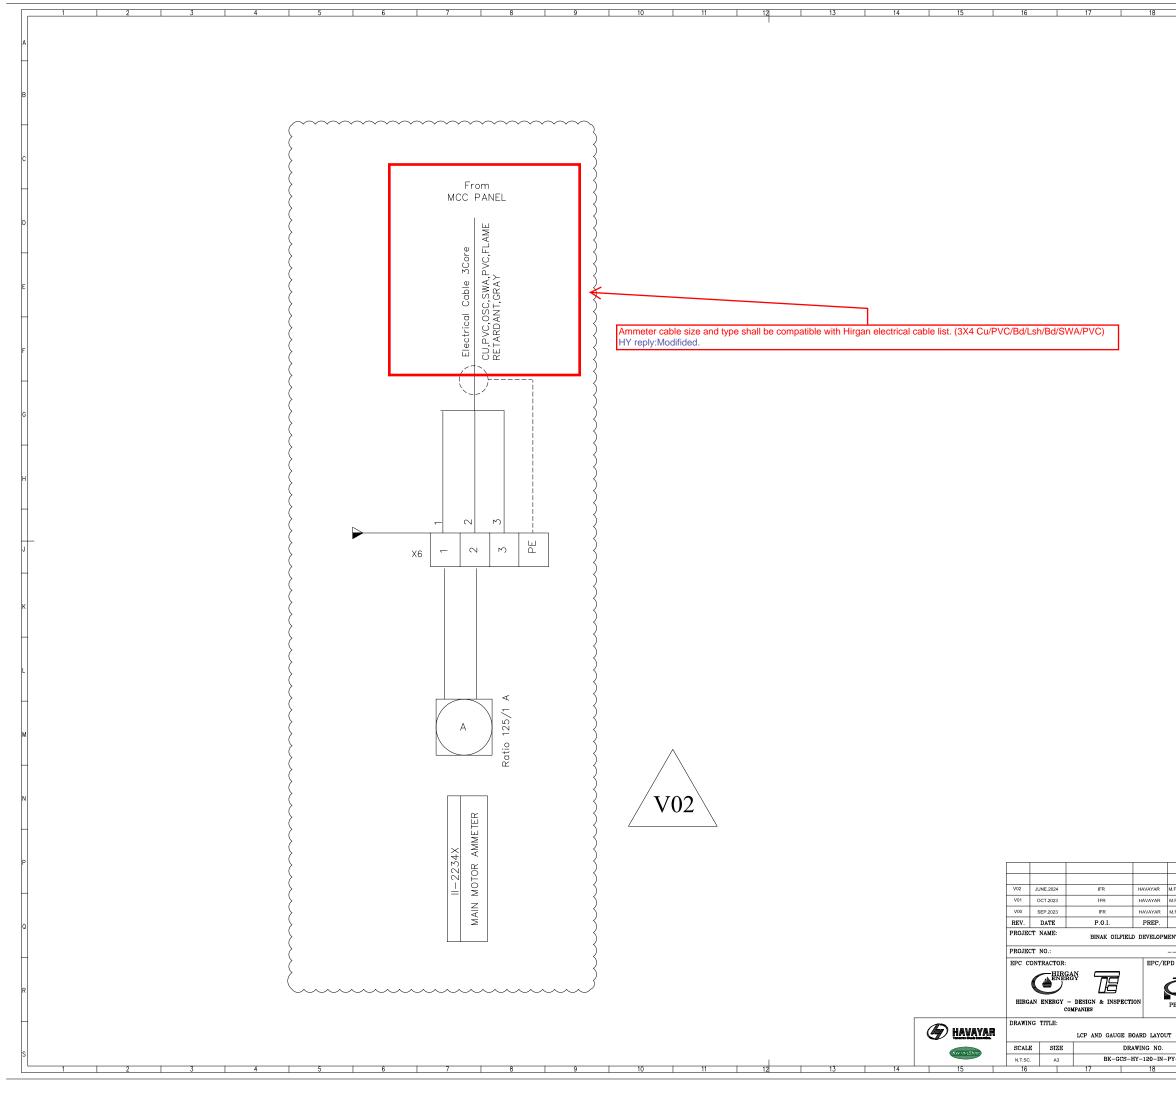

	19		0		21		-	22	A0	, ,
					REFERE	NCE DRAV	WINGS		DWG. NUMBER	
										Α
										Π
										в
										Ħ
										с
										H
			Note	1 :						
			X·A	C	OMP	RE	SSO	RΑ		D
					OMP					\square
					OMF					
										E
										H
										F
										Ц
			Lege	nd :						G
										н
										Ħ
									-	
										1
										Н
										к
										Н
										L
										H
										м
										H
										N
										Ц
										P
FAKHARIAN	M.SADEGHIAN									
FAKHARIAN FAKHARIAN	S.FARAMARZPOU A.M.MOHSENI	R	REV.	ום	ESCRIPTIC	ON	BY C	HECKE	DATE D	
CHK.	APP.	AUT.					ريتم سيتق	رش جہ قل	. شریعہ بانج فاخ نفق قطانہ کلیہ نگ	Q
	E WORK PACH	UNULÖ	G	R	THE C	OPYRIGI	IT THERE	IN ARE	THIS DRAWING TOGETHER WITH THE SOLE PROPERTY OF FIELDS	
CONTRAC		AN							ELOPMENT CKAGES	Π
2	PETROIR. DEVELOP	MENT			1				I	R
EDCO	COMPANY	(DA	TE	SCA	LE	DRAWIN	IG BY	CHECKED BY	
					NSTRUCTI FOR CON			UNLE BY:	SS DRAWING APPROVED	
-0001	SHEET N				LOCATION	1	-		IAL NO.	-s
	19		0		21 Software	Auto	l l	22	File No BK-GCS-HY-120-IN-PY-0001-V0)2.dwg

	PART	LIST			
IN	Description	Qty	Manufacturer	Origin	
1	Ex d IIB+H2 T4 Enclosure FCP241 (1x Window 60x60 mm)	1	S.E.M.C	Iran	
2	Ex d IIB+H2 T4 Enclosure FCP241		3	S.E.M.C	Iran
3	Ex d IIB+H2 Signal Lamp (Red) 24VDC		1	S.E.M.C	Iran
4	Ex d IIB+H2 Signal Lamp (Green) 24VDC		13	S.E.M.C	Iran
5	Ex d IIB+H2 Signal Lamp (Yellow) 24VDC		1	S.E.M.C	Iran
6	Ex d IIB+H2 Selector Switch 3Position LOR		11	S.E.M.C	Iran
7	Ex d IIB+H2 Push Button (Spring Return) Green (1NO+1NC)	11	S.E.M.C	Iran	
8	Ex d IIB+H2 Push Button (Spring Return) Red (1NO+1NC)	11	S.E.M.C	Iran	
9	Ex d IIB+H2 Emergency Stop, Mushroom Head, Stay pot (push & pull) Red (1N	1	S.E.M.C	Iran	
10	Ex d IIB+H2 Push Button (Spring Return) Yellow (1NO+1NC)	1	S.E.M.C	Iran	
11	Ex d IIB+H2 Selector Switch 2Position 1Pole (0-1)	1	S.E.M.C	Iran	
12	Ammeter "Ziegler DE72" 0~125A/CT1A Class 1.5 (Equipped with red line & 61	1	Ziegler	Germany	
13	Ex d IIB+H2 Push Button "LAMP TEST" (Spring Return) Black (1NO+1NC)		1	S.E.M.C	Iran
14	Terminal 2.5 mm ²		179	RAAD	Iran
15	Earth Terminal 2.5 mm ²		94	RAAD	Iran
16	Ex d IIC Cable Gland M50 Type 453-4M (Armoured) BOTTOM OF JB		4	S.E.M.C	Iran
17	Ex d IIC Plug M50 (Type 800) (Armoured) BOTTOM OF JB		2	S.E.M.C	Iran
18	Ex d IIC Plug M40 (Type 800) BOTTOM OF JB		1	S.E.M.C	Iran
19	Ex d IIC Cable Gland M40 Type 453-4M (Armoured) BOTTOM OF JB		1	S.E.M.C	Iran
20	Ex d IIC Cable Gland M25 (Armoured) BOTTOM OF JB		1	S.E.M.C	Iran
21	Ex d IIC Plug M25 (Type 800)		1	S.E.M.C	Iran
22	Silicone Wire		_	SIMCO	Iran


1 2 3 4

1 2 3 4 5

5

6

6 7 8 9

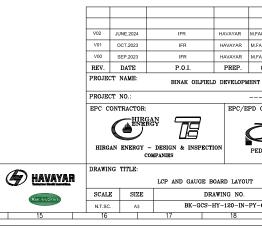

7 8 9 10 11 12 13	14	15	16	17 18 19	20 21 22 A0
			1 1		REFERENCE DRAWINGS DWG. NUMBER
					<u>^</u>
					В
PART LIST	1		1		
Description	Qty	Manufacturer	Origin		C
(1x Window 60x60 mm)	1	S.E.M.C	Iran		
	3	S.E.M.C	Iran		Notel :
VDC	1	S.E.M.C	Iran		X:A COMPRESSOR A
24VDC	13	S.E.M.C	Iran		X:B COMPRESSOR B
24VDC	1	S.E.M.C	Iran		X:C COMPRESSOR C
ion LOR	11	S.E.M.C	Iran		
eturn) Green (1NO+1NC)	11	S.E.M.C	Iran		
eturn) Red (1NO+1NC)	11	S.E.M.C	Iran		F
nroom Head, Stay pot (push & pull) Red (1NO+1NC) lockable	1	S.E.M.C	Iran		-
eturn) Yellow (1NO+1NC)	1	S.E.M.C	Iran		
ion 1Pole (0-1)	1	S.E.M.C	Iran		Legend :
CT1A Class 1.5 (Equipped with red line & 6time)	1	Ziegler	Germany		
EST" (Spring Return) Black (1NO+1NC)	1	S.E.M.C	Iran		н
	179	RAAD	Iran		
	94	RAAD	Iran		
3-4M (Armoured) BOTTOM OF JB	4	S.E.M.C	Iran		J
oured) BOTTOM OF JB	2	S.E.M.C	Iran		
TOM OF JB B-4M (Armoured) BOTTOM OF JB	1	S.E.M.C S.E.M.C	Iran		ĸ
ed) BOTTOM OF JB	1		Iran		
	1	S.E.M.C	Iran		
	1	S.E.M.C	Iran		L
7	-	SIMCO	Iran		
					м
Size of gland shall be					N
rechecked and modified based on above mentioned items.					H
HY reply: Hirgan					P
			V02 JU	NE-2024 IFR HAVAYAR M.FAKHARIAN M.SADEGHIAN	
			V01 O	27.2023 IFR HAVAYAR M.FAKHARIAN S.FARAMARZPOUR 2P.2023 IFR HAVAYAR M.FAKHARIAN A.M.MOHSENI	REV. DESCRIPTION BY DATE CHECKED
			REV. PROJECT		AUT. در محم ب دن ی فن علی من من من الله می من من الله من من علی والی . الحک الله من
			PROJECT D	10.:	N.I.S.O.C./ FIELDS
			EPC CONT	ENERGY TO PETROIRAN	
			HIRGAN	ENERGY - DESIGN & INSPECTION COMPANIES DEVELOPME PEDCO COMPANY	SNT R RAWING BY CHECKED BY
	Γ		DRAWING	ITLE:	NO CONSTRUCTION PERMITTED UNLESS DRAWING APPROVED
		Kwaasha	SCALE	LCP AND GAUGE BOARD LAYOUT SIZE DRAWING NO. SHEET NO.	S S
7 8 9 10 11 12 13	14	15	N.T.SC.	A3 BK-GCS-HY-120-IN-PY-0001 12 OF 12 17 18 19	V02 20 21 22 AO Software Autocol File No. BK - GCSHY -120IN BY0001 V02. diwr No. BK GCS HY -120 IN BY 0001 V02. diwr