
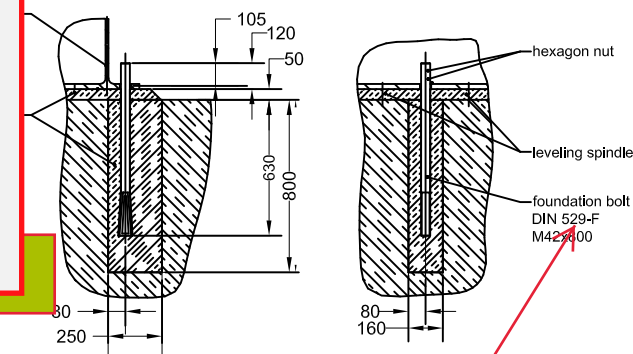


- با توجه به اینکه اطلاعات تکمیلی از سوی مشاور ارائه نشد است ، عمده کامنت های قبلی سازه ای به قوت خود باقی است. از جمله :
- 1- فونداسیون پلان (ابعاد حداقلی پیشنهاد سازنده ؟) و بارهای دینامیکی و استاتیکی کمپرسور و موتور ارائه شود(نیروهای Primary , Secondary)
 - 2- CG کمپرسور و موتور بایستی معرفی گردد و فواصل آنها مشخص شود
 - 3- تیپ و ضخامت گروت
 - 4- تایپ، سایز و پروجکشن و تامین کننده انکربولت و معرفی ابعاد انکرباکس فواصل و تعداد انکر بولت ها معرفی گردد
 - 5- جهت شمال در پلان معرفی گردد
 - 6- وزن موتور و کمپرسور به طور جداگانه ارائه گردد
 - 7- RPM کمپرسور و موتور
 - 8- تغییر مکان و سرعت مجاز ارتعاش ارائه گرد
 - 9- با توجه به ترازاها مد نظر فونداسیون و تجهیز ، حد اقل ارتفاع مورد نیاز هوک جرثقیل کنترل شده است

HY Replies to comments:

- 1- Noted. Please check new revision of GAD
- 2- Noted. Please check new revision of GAD
- 3- Epoxy Grout G3
- 4- Please check new revision of GAD
- 5- Please check new revision of GAD
- 6- Please check new revision of GAD
- 7- Please check new revision of GAD
- 8- Please check new revision of GAD
- 9- Permitted deviation for leveling mentioned in GAD. Its not in HAVAYAR 's scope.

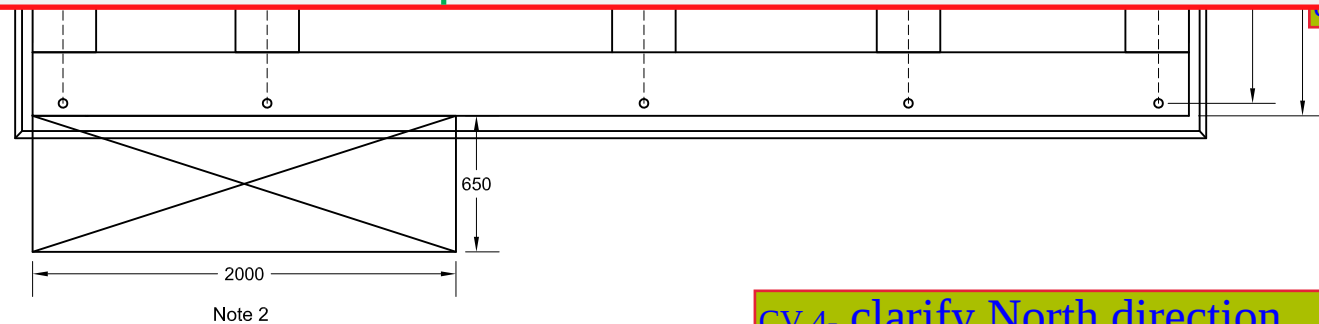

CV.3- follow standard drawing

- cv.4- clarify North direction.
 cv.5- shear and moment of wind and seismic load shall be reported.
 cv.6- dynamic loads shall be reported.
 cv.7- clarify anchor bolts supplier.

تیپ مدرک Foundation Plan

Code1	☐ Approved (Vendor shall issue "AFC"/ "FIN" status)
Code2	☐ Approved as noted (Vendor to amend and submit the "Issued for Approval" status)
Code3	☐ Commented (Vendor to amend and submit the "Issued for Approval" status.)
Code4	☐ Rejected (vendor to resubmit with same revision)
The above checking result by Purchaser shall in no way relieve Vendor of any liability, obligation and responsibility out of the purchase order and the mutual agreement in writing	
Oil Design & Construction Co. DATE : DEPT: Signature :	
Only for internal review	
CV	PI
ST	MC
EL	PR
IN	SF
ME	HV
MA	TC

00	10.AUG.2022	ISSUED FOR APPROVED	Z.Bahram	V.Nayeri	H.Azam
REV.	DATE	DESCRIPTION	PREP.	CHK.	APP.

--	--

DRAWING TITLE:
 General arrangement drawing with foundation plan
 - C-3301-B With Tie Point List And Location

PREP.:	CHECK:	APPR.:
CONT. JOB No.:	CONT. DWG. No.:	

DOCUMENT No.:	SC.:N.T.S
SIZE: A3	

PROJ.	P.O NO.	DISC.	DOC TYPE	TAG NO.	SERIAL NO.	REV.	SHEET NO.:
SDHT	TG0018	RE	VDWG	C3301B	006	00	3 OF 3

FILE REF. ADDRESS:
 F01: IFA