## **LCP COMPRESSOR**


14

9


2

3 4


<b>Enclosure Specification</b>	
Tag number	LCP-2101X (Note 1)
Marking acc to 94/9/EC directive	Ex II 2 G D
Marking acc. to IEC	Ex d IIB+H2 T4
Ingress Protection to IEC 60529	IP66
Permissible Ambient Temperature	5 °C TO 55° C
Material	Copper Free Aluminium
Colour Of Enclosure	RAL 7035
Thickness	20mm±5mm

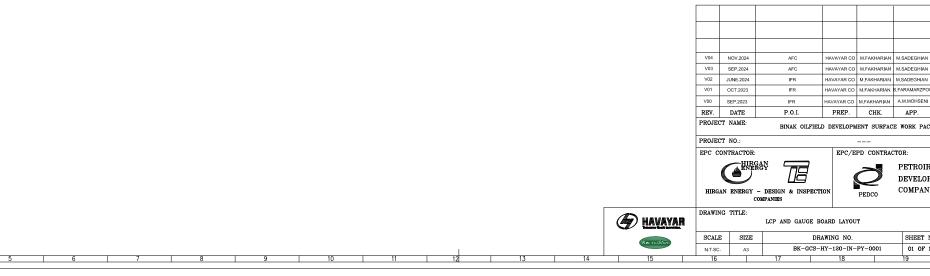



15	16		17	18		19		20	21		22	A0		
			·					BK-GCS-H				DWG. NUMBER		
											ABLE LIST	A		
												В		
												с		
									4					
								Note	1:			D		
								X۰۵	COMPR	FSSOR	Δ			
				_				X:0	C COMPR	ESSOR	C			
												Ē,		
								<u>Not</u>	<u>e2 :</u>					
								WI	RE 1.5mm <sup>-</sup>	^2 BLA	CK			
								S:1;	oono wiro					
											ENT CABLE LIST	F		
							(	Wir	e number r	rocedu	re· Xn_m	$\sim$ H		
						$\wedge$	(	n: S	Strip number	er m:	Terminal n	umber		
					/	/	(	Ex:	X1-01					
								$\sum_{i=1}^{n}$		~~~~~	~~~~~~~~~~~~~~~~~~~~~~~~~~~~~~~~~~~~~~~	~~		
					- / ` <b>`</b>	VOĂ	$\backslash$		aond -					
						V 04	$\langle \rangle$		gena .					
					<i></i>							н		
												J		
												v l		
•												<u> </u>		
1				V04 Wire number procedure: Xn-m n: Strip number m:Terminal number Ex:X1-01										
												L		
												H		
												м		
												H		
												N		
												H		
											1	P		
	V04 V03	NOV.2024 SEP.2024	AFC	HAVAYAR CO HAVAYAR CO		M.SADEGHIAN				-		[]]		
	V02	JUNE-2024	IFR	HAVAYAR CO	M.FAKHARIAN	M.SADEGHIAN								
	V01 V00	OCT.2023	IFR	HAVAYAR CO	M.FAKHARIAN		R	REV.	DESCRIPTION	BY		]		
	REV.	SEP.2023 DATE	IFR P.O.I.	HAVAYAR CO PREP.	M.FAKHARIAN CHK.	A.M.MOHSENI	AUT.		و «رقش دی، «خرش ادای– و ای–			. شريوم باورج ورخ		
	PROJEC	CT NAME:	BINAK OILFIEL	DEVELOPM	IENT SURFAC	E WORK PACH	AGES		THE ORIGINAL A	ND ALL COPIES	DWG. NUMBER ANT CABLE LBT DR A DR A DR B DR C ACK y Vendor. hure: Xn-m n: Terminal number CHECKED CH			
		T NO.:			Image region     Image region<									
	EPC C	ONTRACTOR:		EPC/E	PD CONTRAC									
					$\sim$				JOR	"OIX				
	HIRG	AN ENERGY	– DESIGN & INSPECTI	ON	PEDCO			DA	TE SCALE	DRAWING	BY CHECKED BY			
		c	OMPANIES		L PDCO									
HAVAYAR	DRAWIN	G TITLE:	LCP AND GAUGE BO	DARD LAYOU	т							PPROVED		
	SCALI	SIZE		WING NO.		SHEET N	0. REV							
Kw.m.(Shin	N.T.SC			IY-120-IN-	PY-0001	01 OF 1		DODGE	SI DUCATION SI		SUMAL NO.	s		
15	16		17	18		19		20	21 Software	Autocod	22 File No 18105 V04.dw	AO		

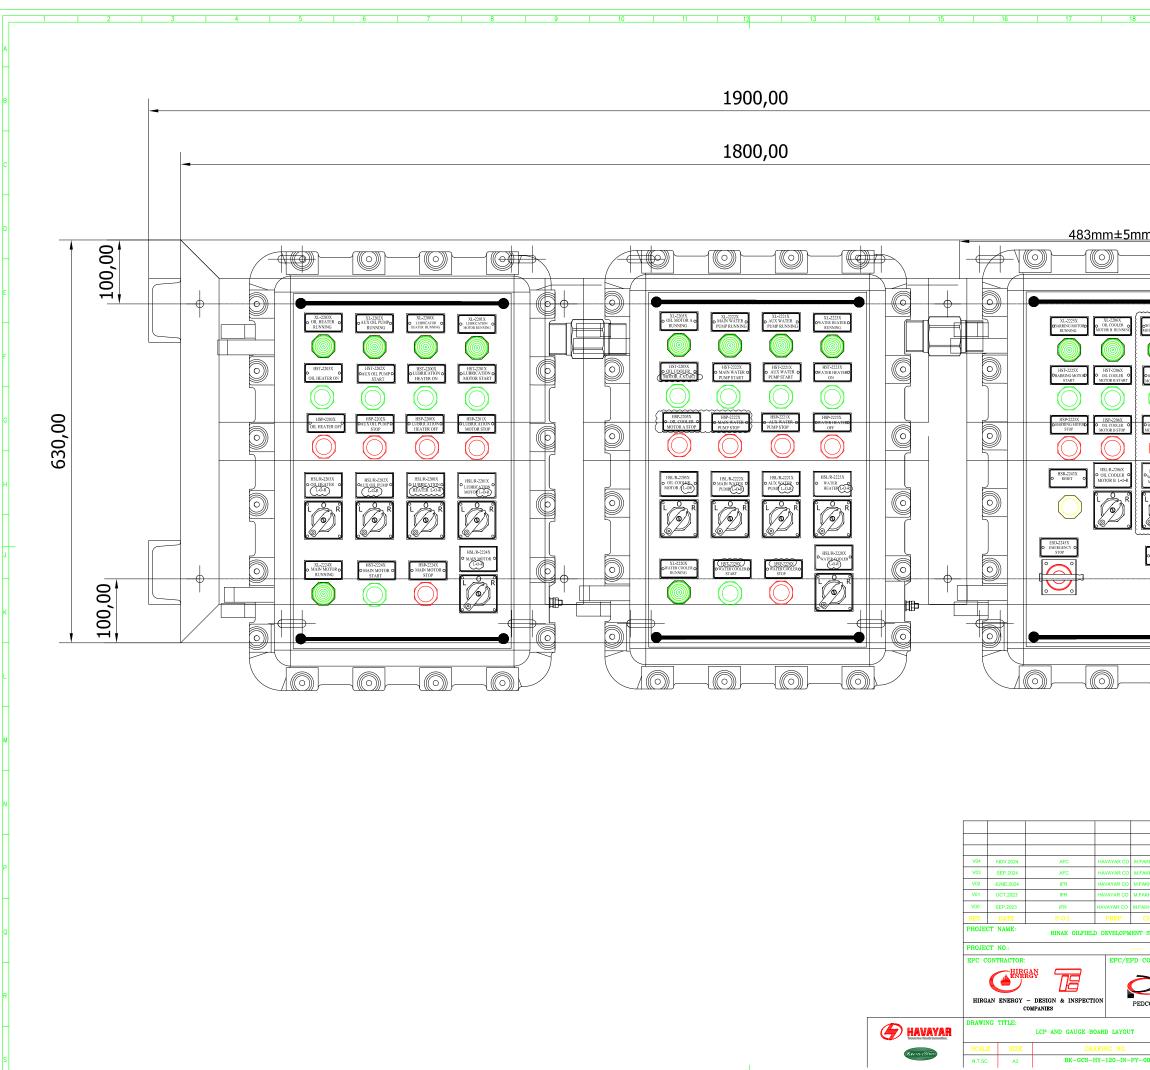


אמרואמווא MSADEGHIAN אמרואמווא MSADEGHIAN   אמרואמווא MSADEGHIAN BY DATE   אמרואמווא SPARAMARZPOUR BY DATE   NGHARIAN SPARAMARZPOUR BY DATE   CHK. APP.   AUT. معلى في محلي في محليل في محلي في محل							<u>8*Ø</u>	12,00	B C C D E F G G H J L L
CHK. APP. AUT. حال المحال الم	KHARIAN	M.SADEGHIAN M.SADEGHIAN S.FARAMARZPOUR		- REV.	DESCRIPTION	1			P
N.I.S.O.C./ FIELDS	KHARIAN		AUT.		THE ORIGINAL THE CO	م س بيتق قح و ه AND ALL CO	نہ علیہ تک رش ب قلی خ PIES OF THIS DR.	AWING TOGETHER W	
ONTRACTOR: BINAK OILFIELD DEVELOPMENT - SURFACE WORK PACKAGES	KHARIAN S KHARIAN HK.		GES			NIS	.0.C./ FIELI	)S	
PETROIRAN DEVELOPMENT COMPANY DATE SCALE DRAWING BY CHECKED BY NO CONSTRUCTION PERMITTED UNLESS DRAWING APPROVED APPROVED FOR CONSTRUCTION BY: SHEET NO. REV. BUDGET REP. LOCATION SIZE CLASS SERIAL NO.	KHARIAN S KHARIAN CHK. SURFACE	E WORK PACKA	GES	- <del></del>	BINA	K OILFIELI	D DEVELOPM	ENT	

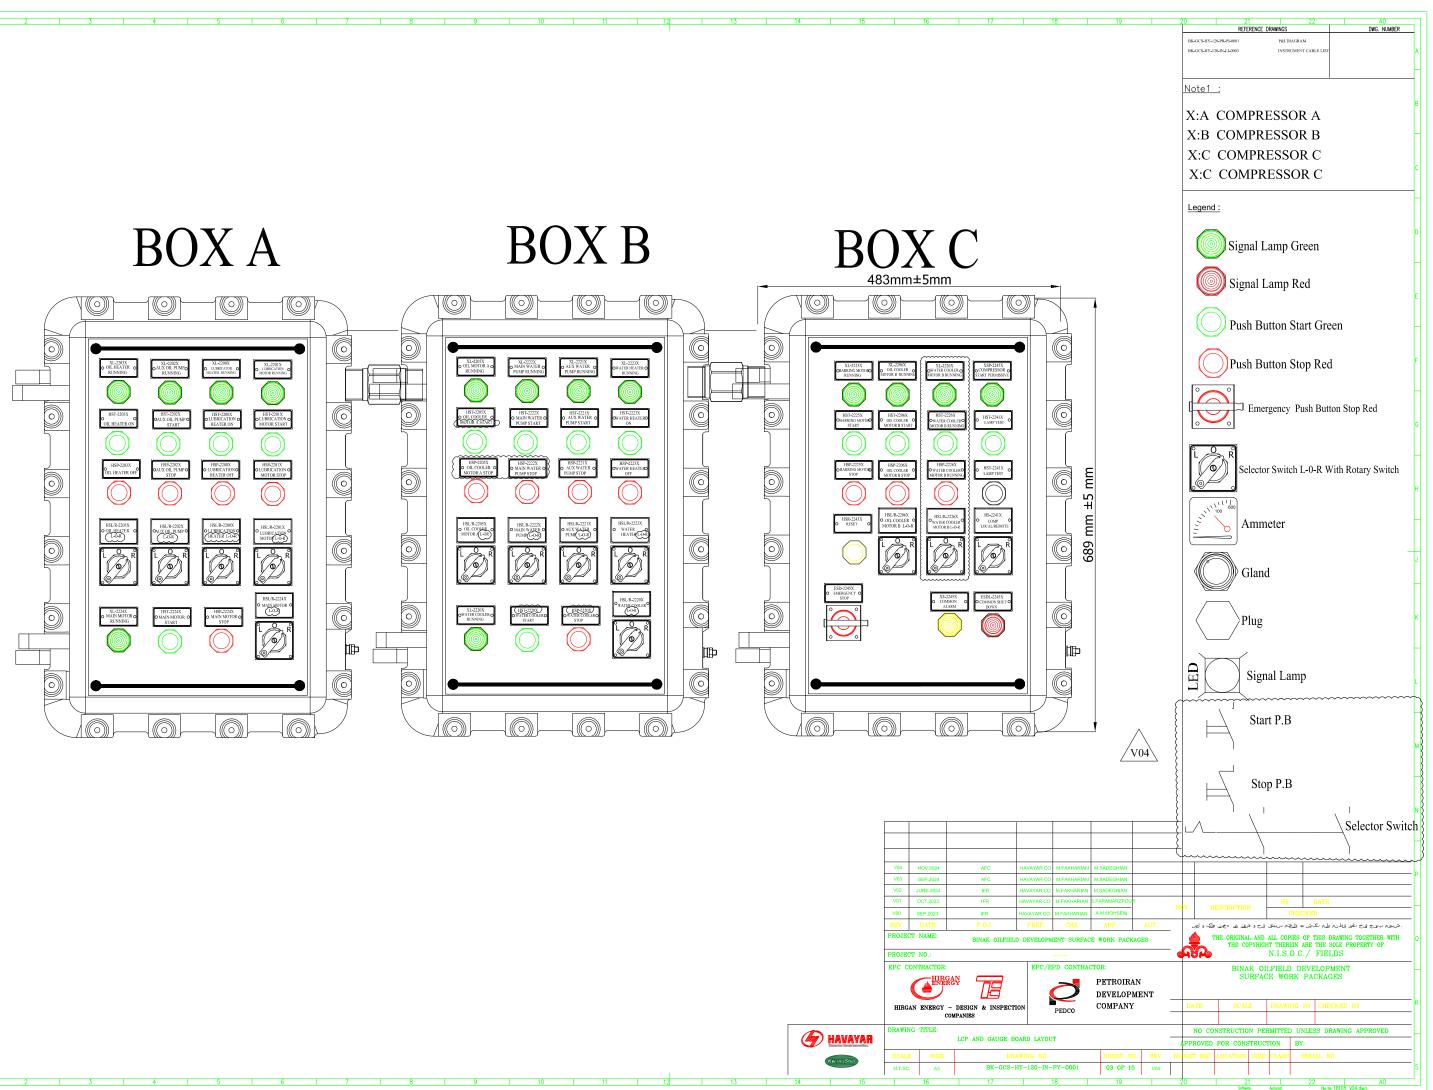


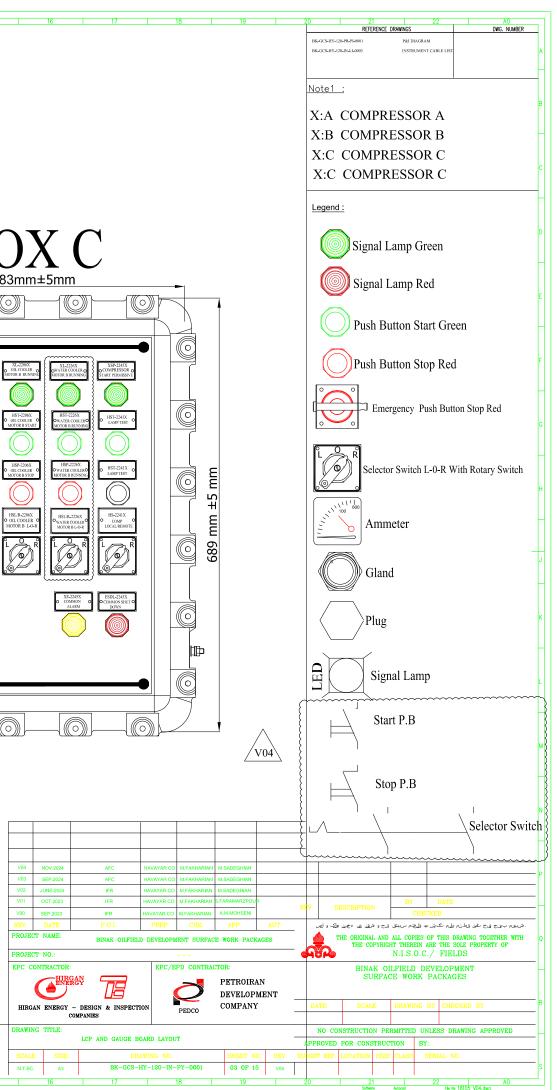


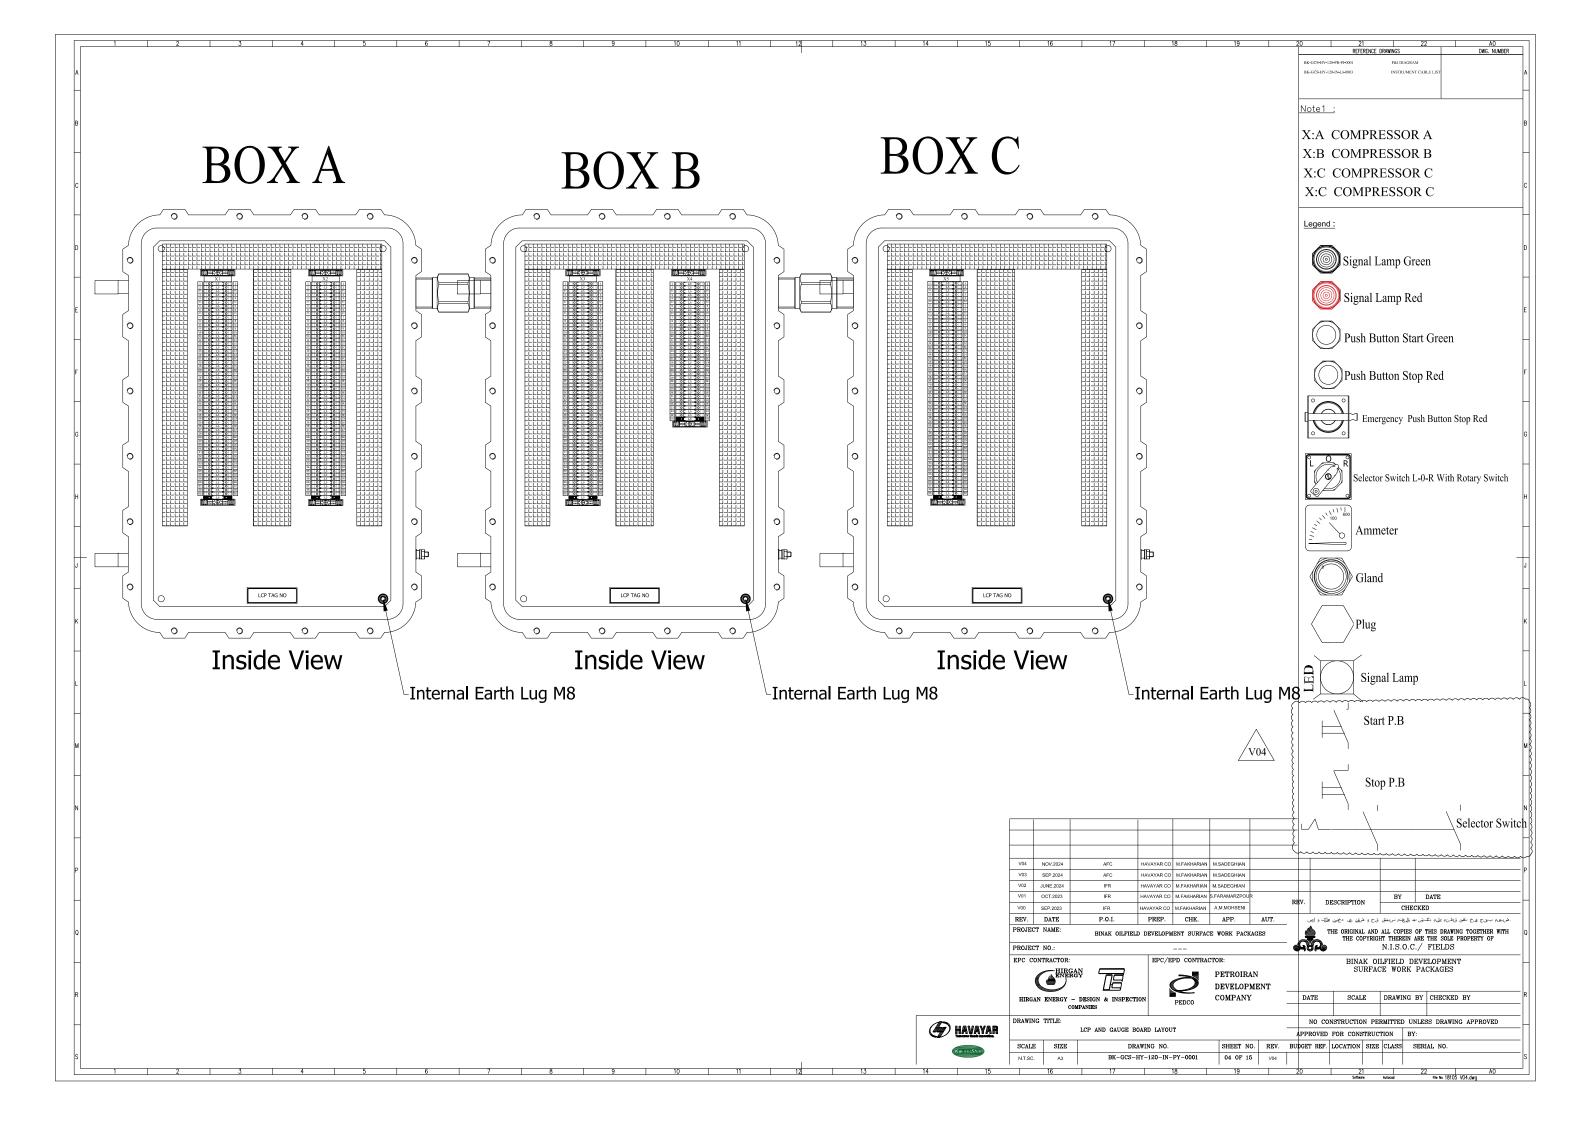



## BOX A

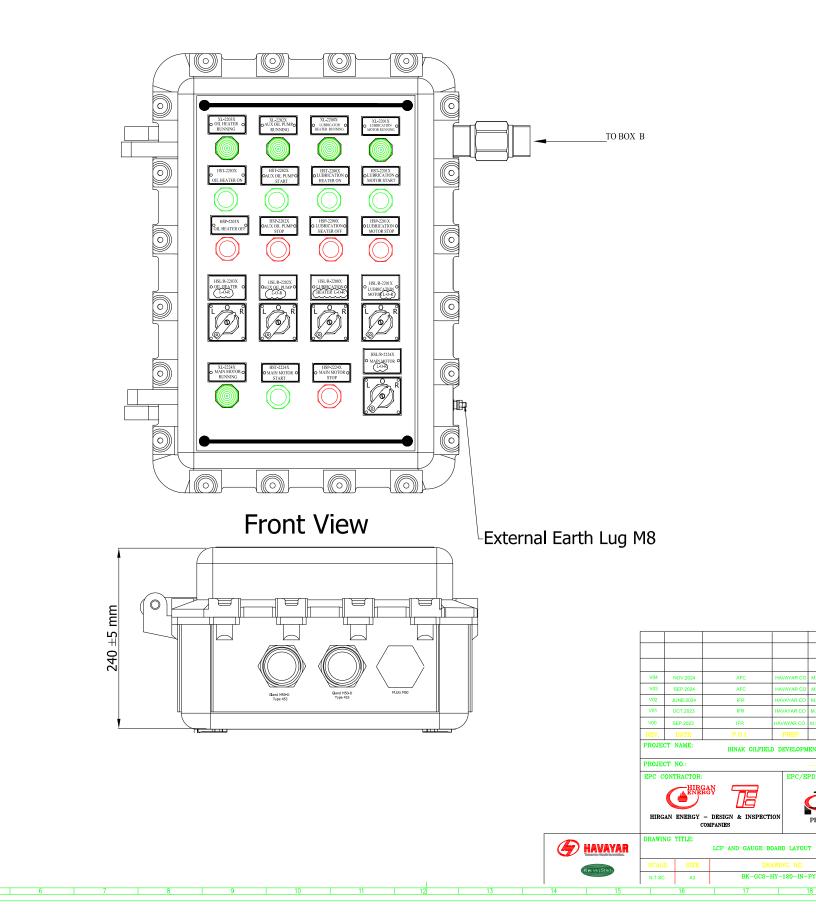

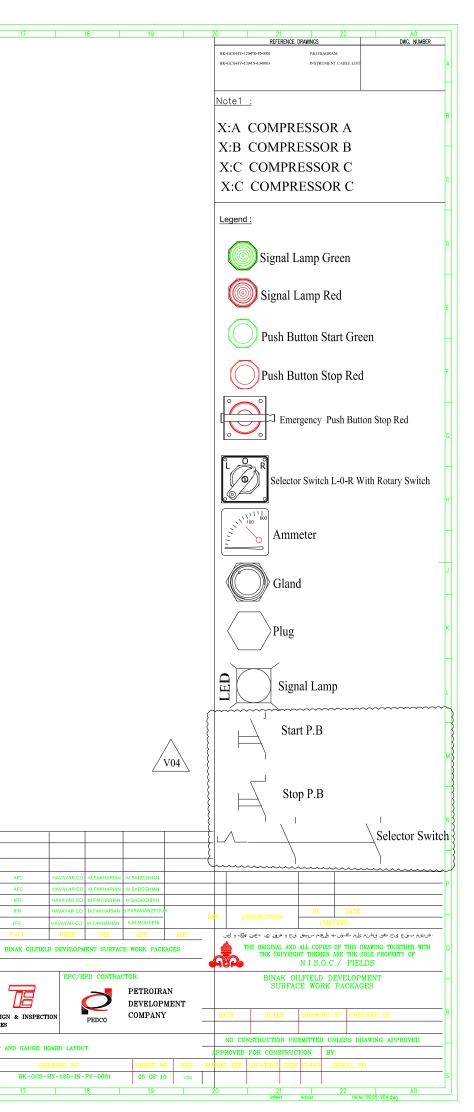


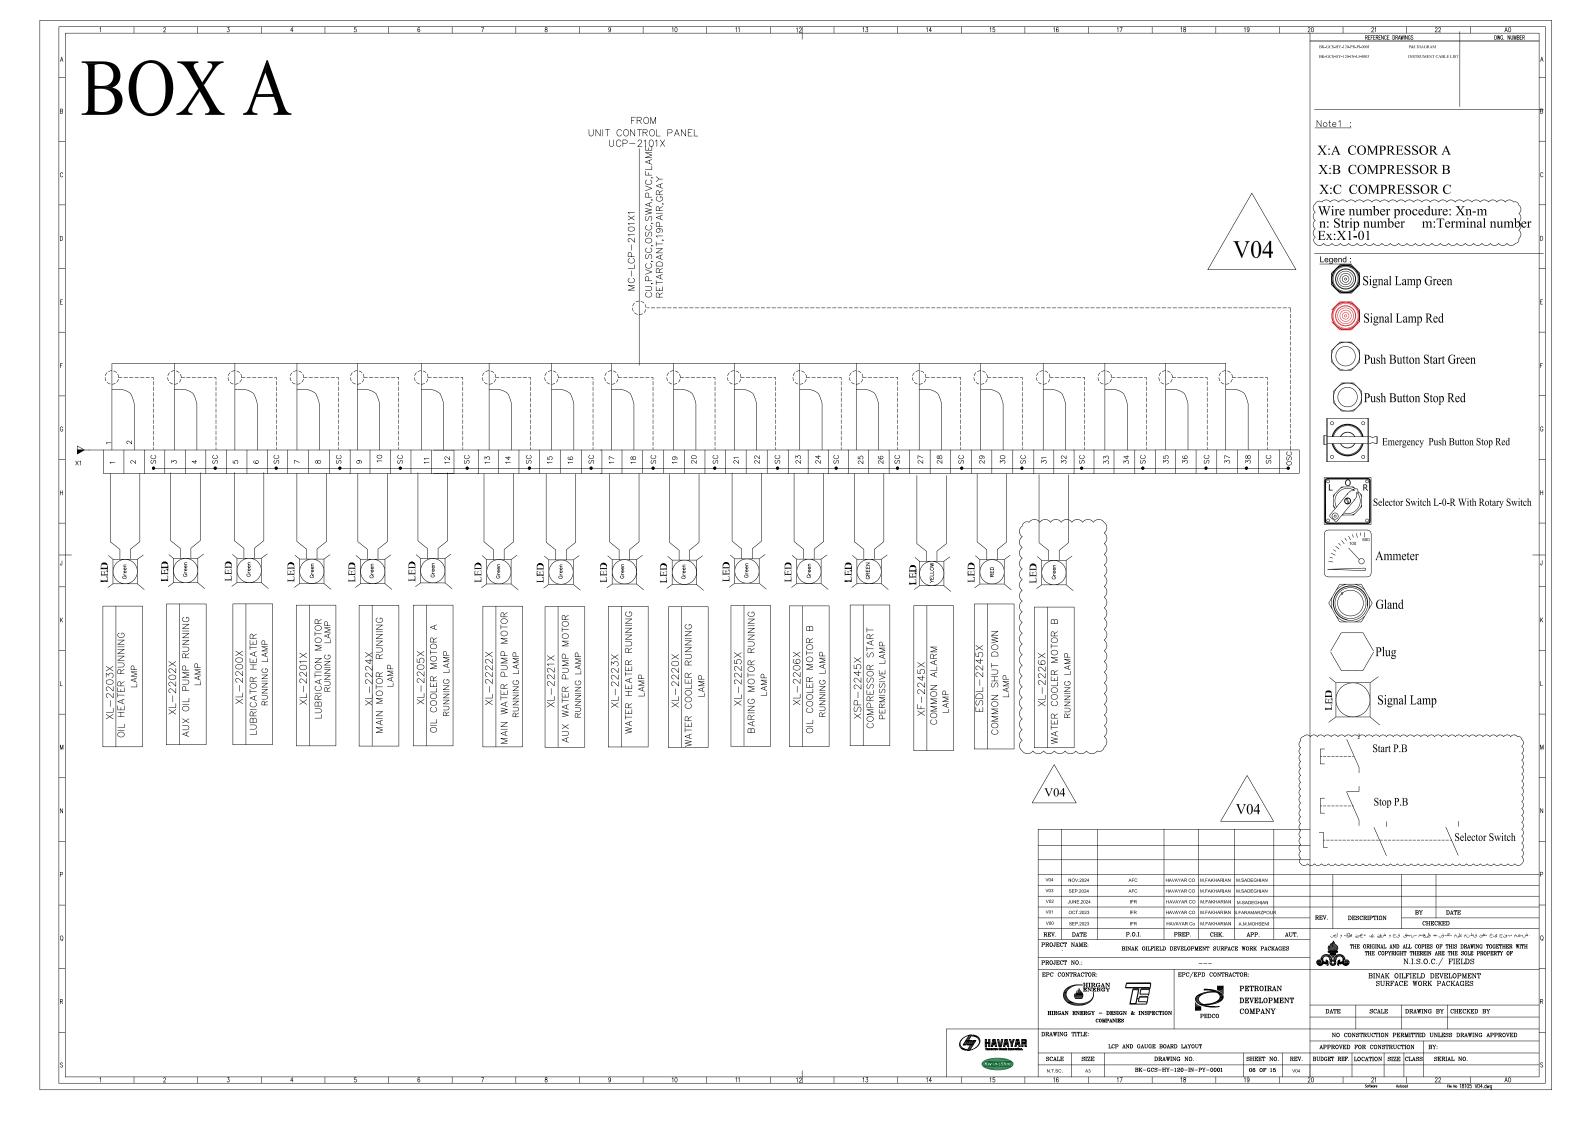


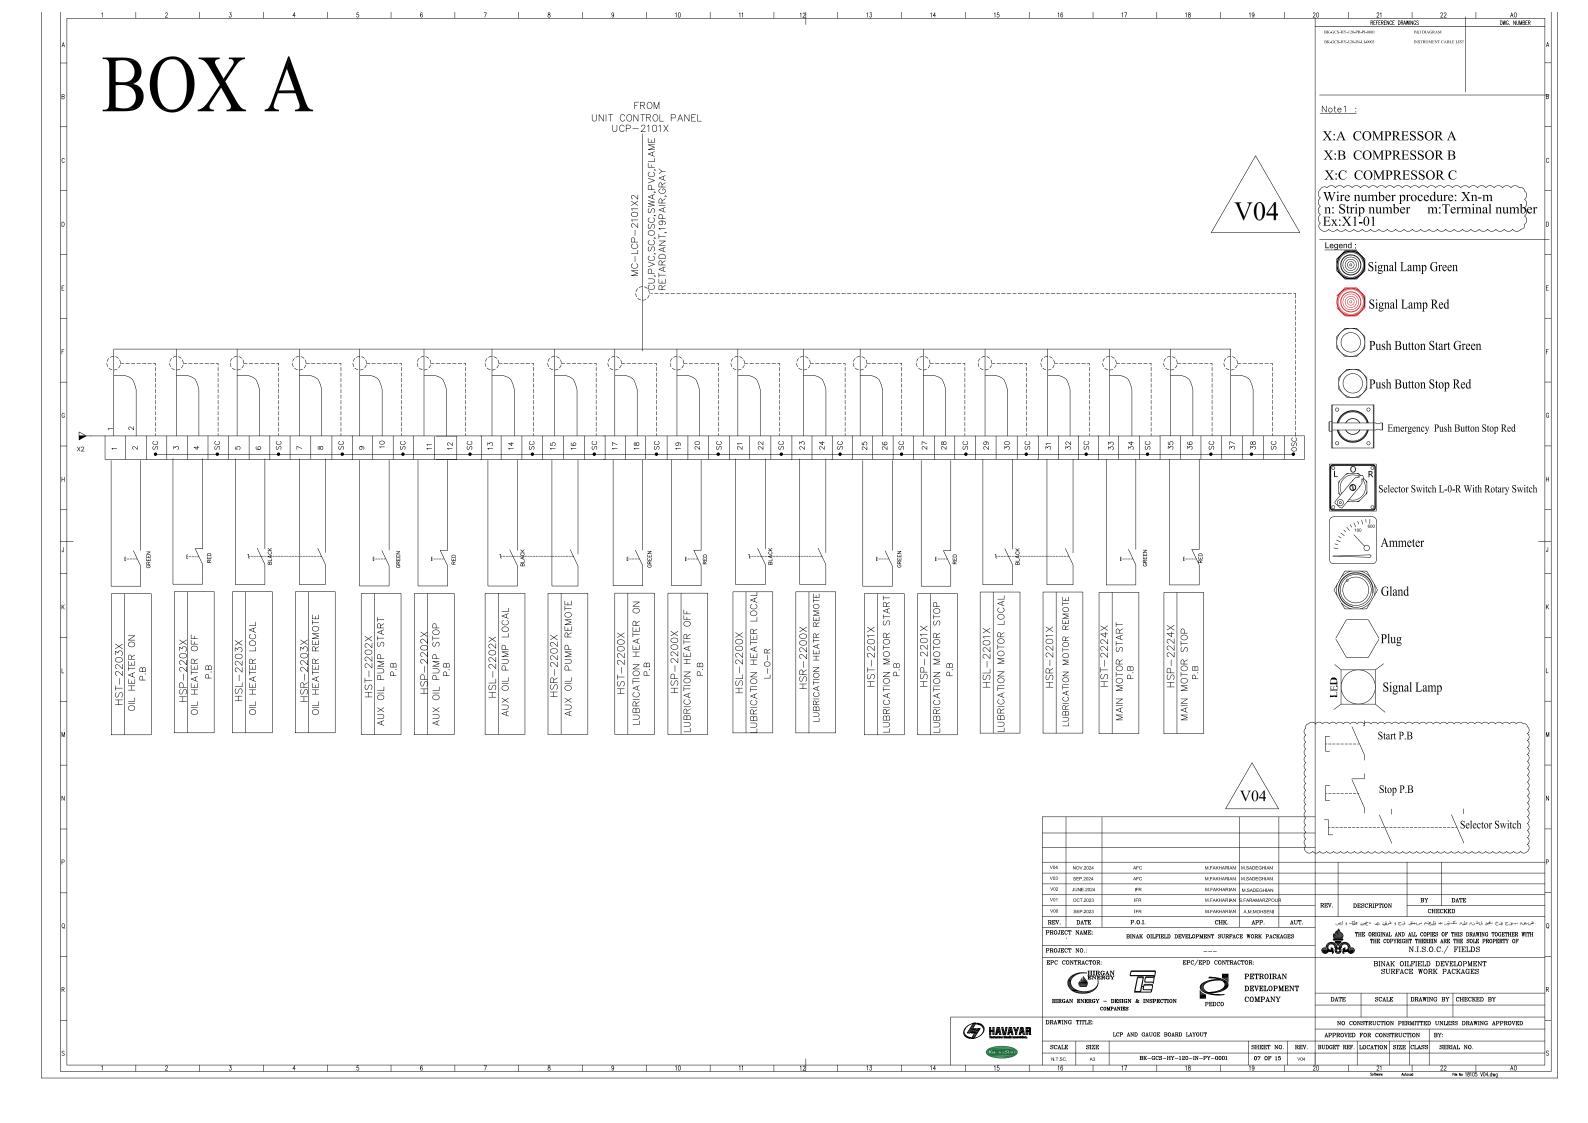


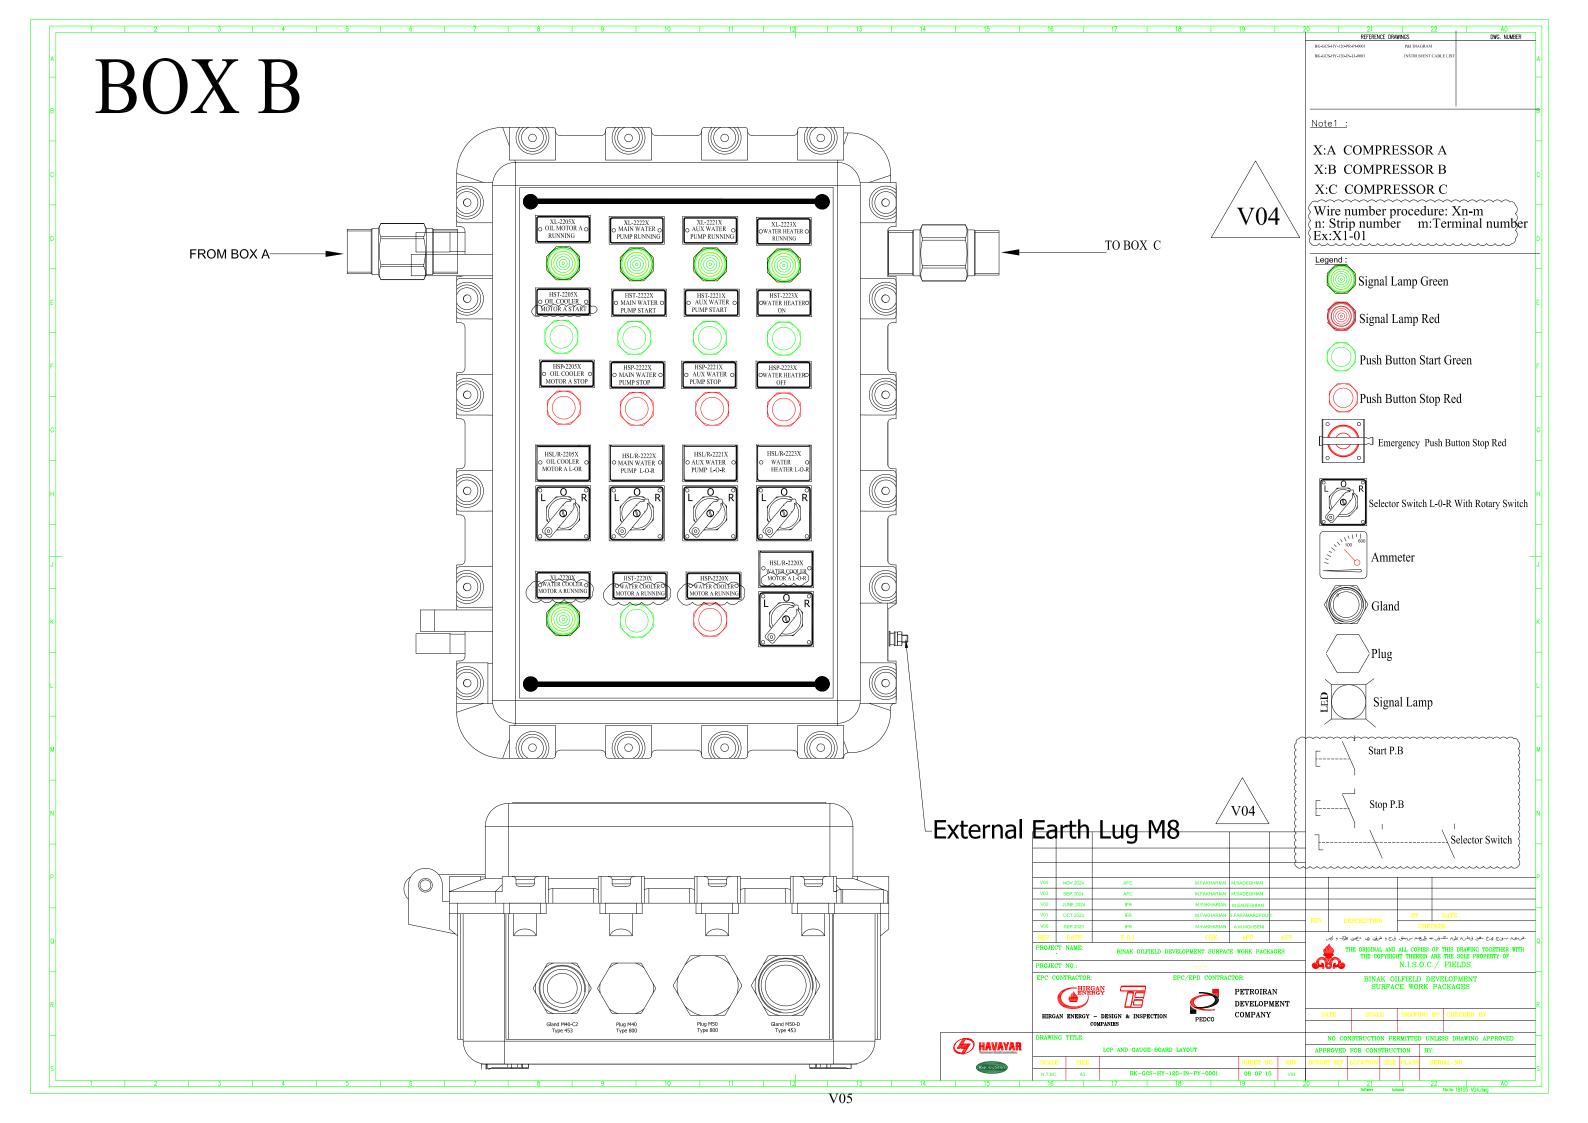


BOXB	FROM UNIT CONTROL PANEL UCP-2101X
HSL-2224X MAIN MOTOR LOCAL MAIN MOTOR LOCAL MAIN MOTOR LOCAL MAIN MOTOR ROMOTE MAIN MATER PUMP STRAT MAIN WATER PUMP STRAT MAIN WATER PUMP STRAT	P.B. Marter PUMP SIL-2222X ATER PUMP REMOTE SIL-222X ATER PUMP REMOTE B.B. Marter PUMP Marter PUMP START P.B. Marter PUMP START MATER PUMP START P.B. Marter PUMP LOCAL B.B. Marter PUMP LOCAL TER PUMP LOCAL P.B. Marter PUMP LOCAL TER PUMP LOCAL P.B. Marter PUMP LOCAL TER PUMP LOCAL P.B. Marter PUMP REMOTE
	9   10   11   12   13   14   15   16   17   18

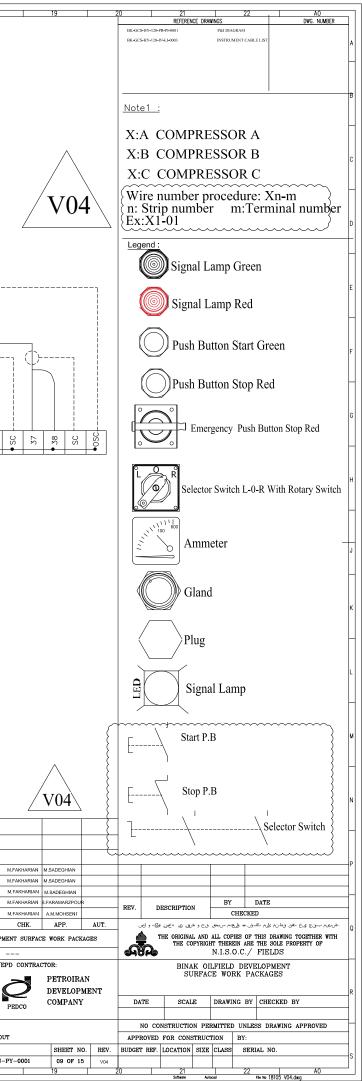


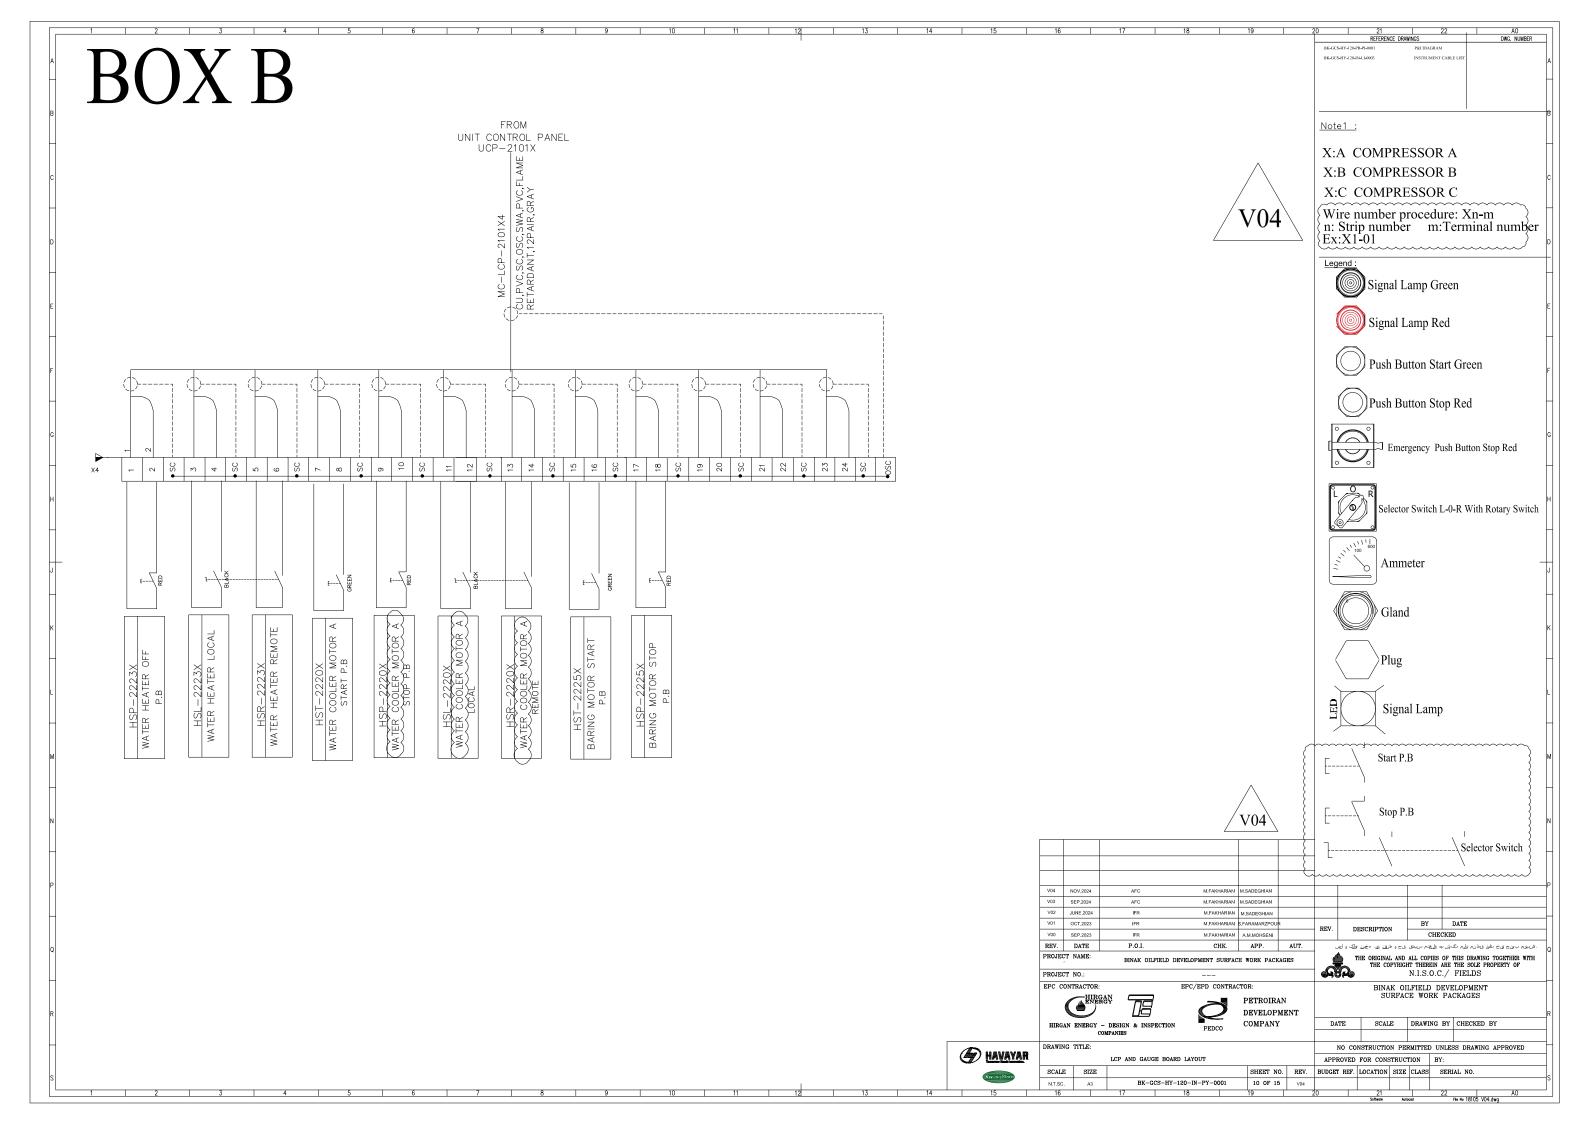

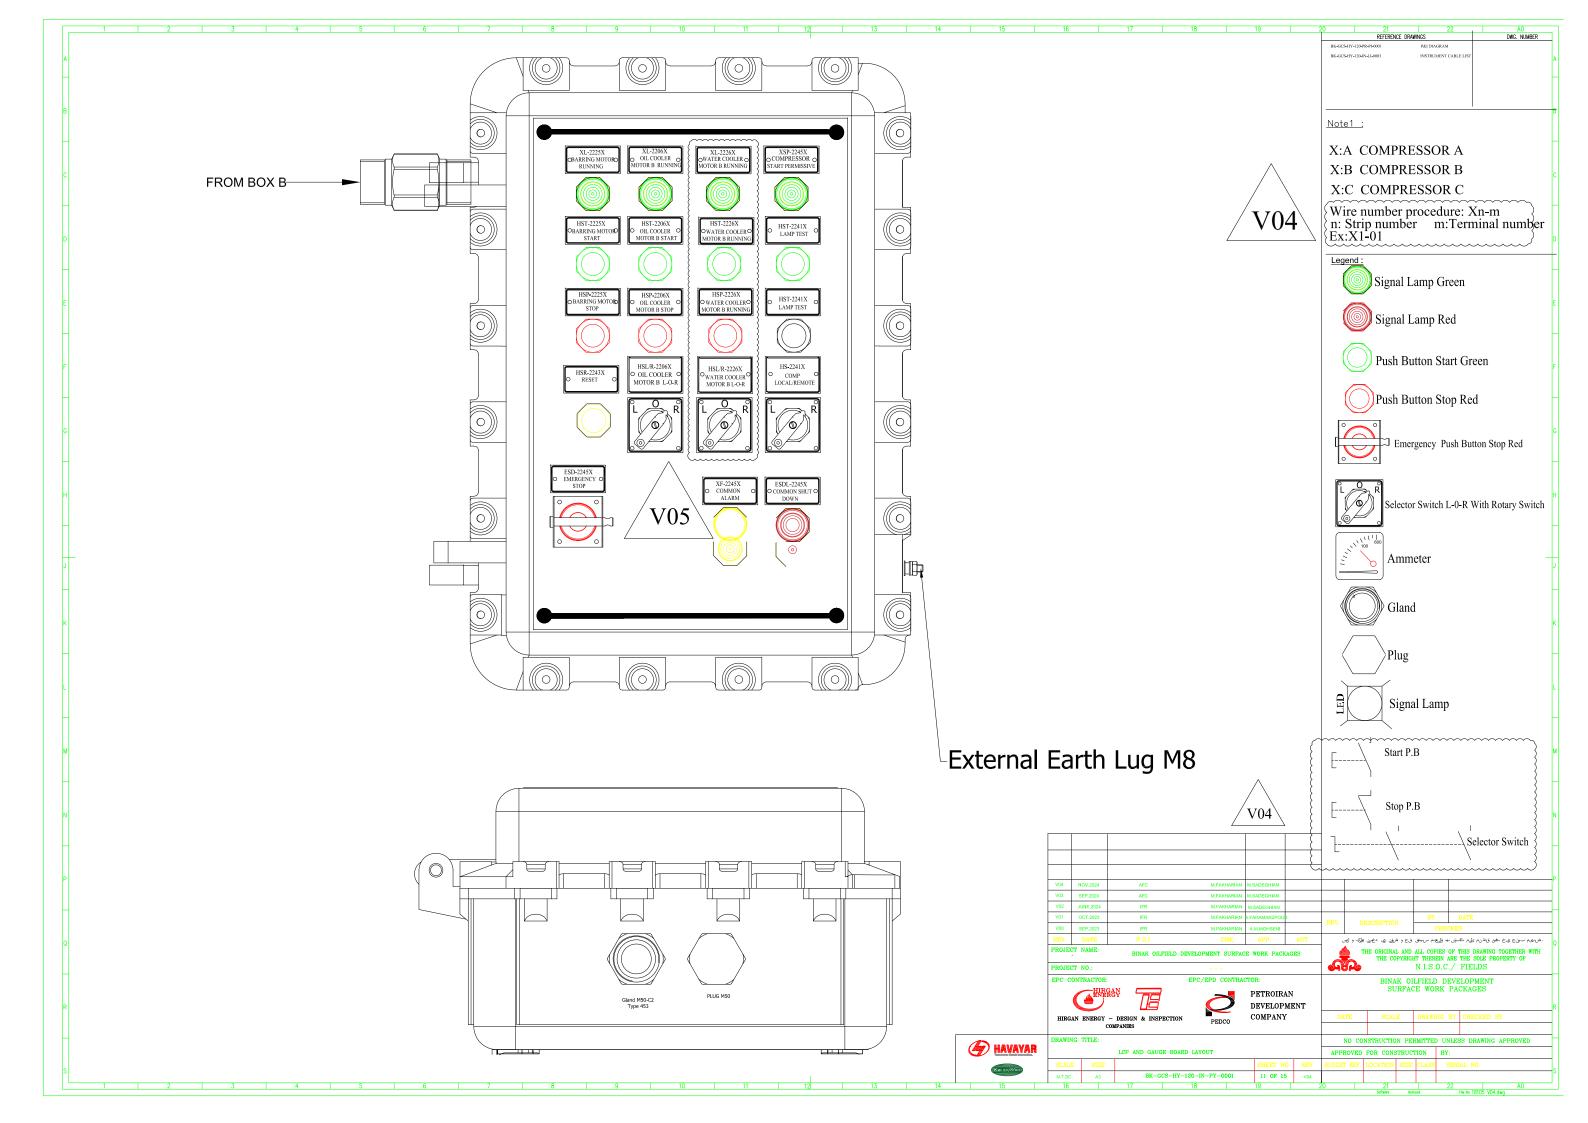


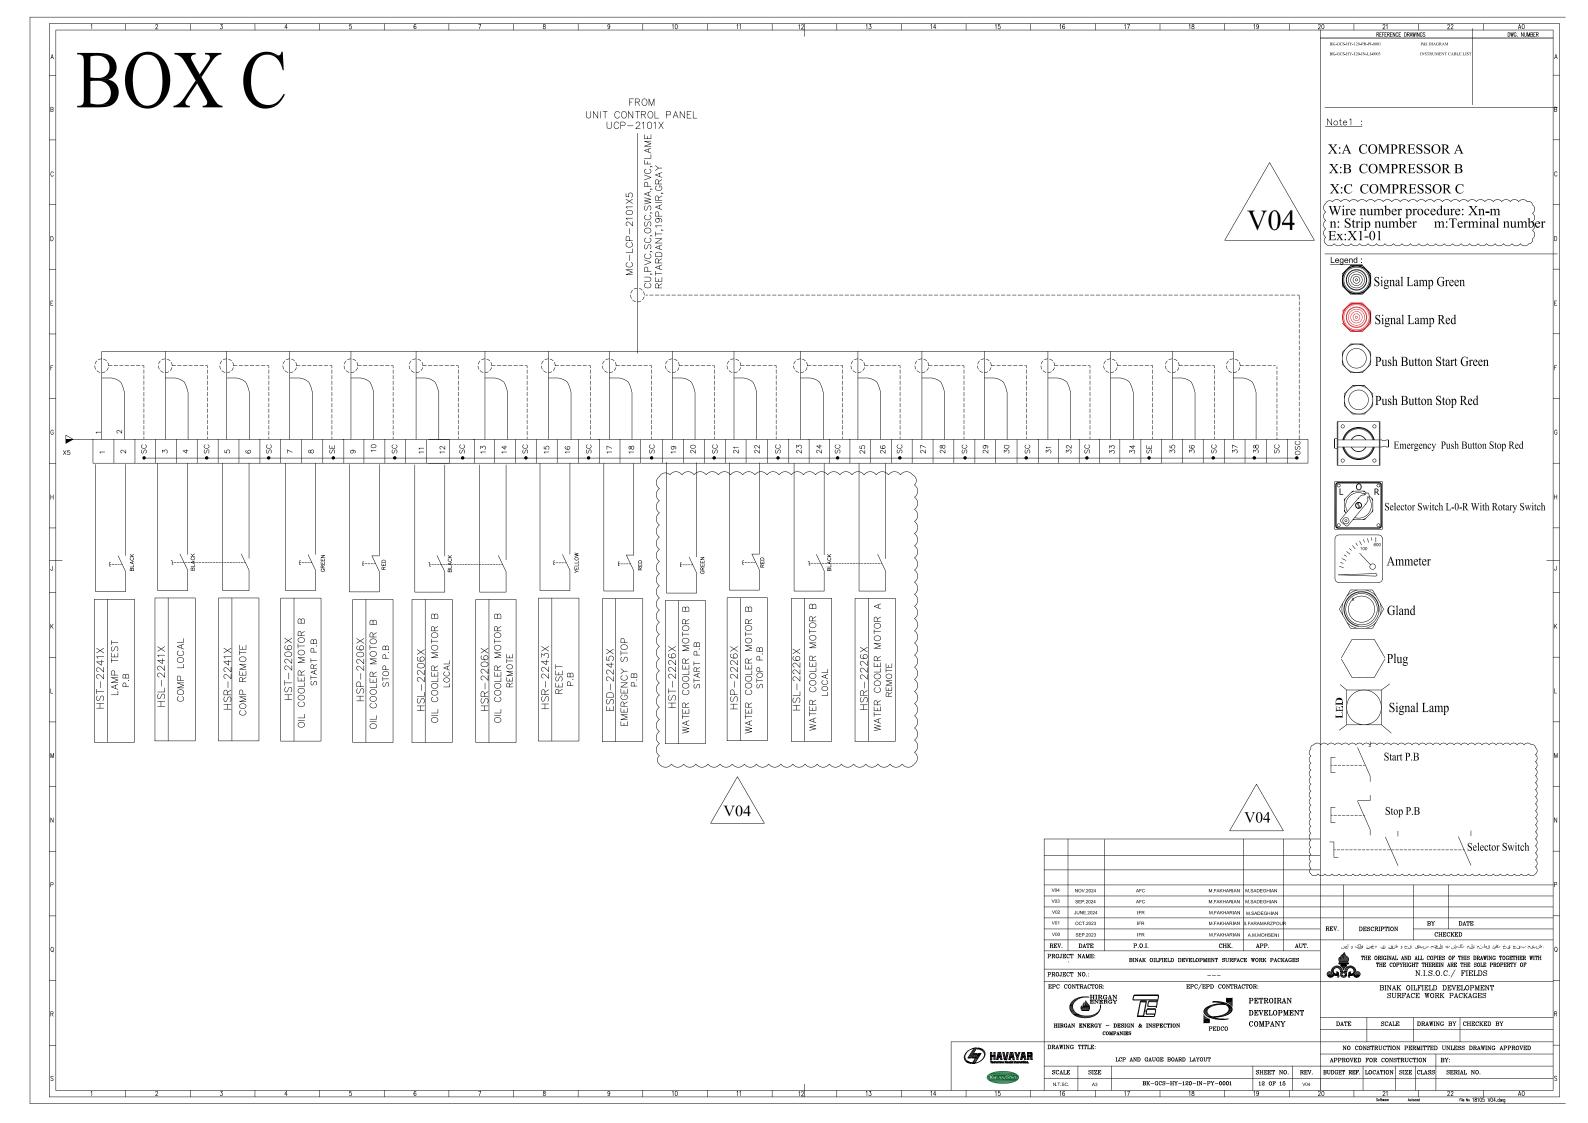


AMMETER GAUGE BOARD	
MANAGER MANAGER 11-22-5X	V04
	Image: Size marked for the size marked for

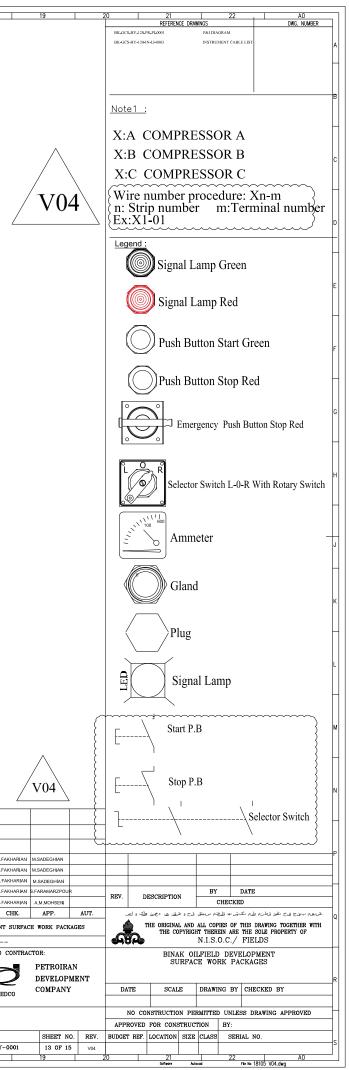

L		PART LIST						
	IN	Description	Qty	Manufacturer	Origin			
	1	Ex d IIB+H2 T4 Enclosure FCP241 (1x Window 60x60 mm)	1	S.E.M.C	Iran			
	2	2 Ex d IIB+H2 T4 Enclosure FCP241 2						
	3	Ex d IIB+H2 Signal Lamp (Red) 24VDC	1	S.E.M.C	Iran			
	4	Ex d IIB+H2 Signal Lamp (Green) 24VDC	13	S.E.M.C	Iran			
-	5	Ex d IIB+H2 Signal Lamp (Yellow) 24VDC	1	S.E.M.C	Iran			
F	6	6 Ex d IIB+H2 Selector Switch 1Pole 3Position (L-O-R)						
F	7	Ex d IIB+H2 Selector Switch 1Pole 2Position (L-R)	1	S.E.M.C	Iran			
F	8	Ex d IIB+H2 Push Button (Spring Return) Green (1NO+1NC)	13	S.E.M.C	Iran			
F	9	Ex d IIB+H2 Push Button (Spring Return) Red (1NO+1NC)	12	S.E.M.C	Iran			
F	10	Ex d IIB+H2 Push Button (Spring Return) Yellow (1NO+1NC)	1	S.E.M.C	Iran			
-	11	Ex d IIB+H2 Push Button (Spring Return) Black (1NO+1NC)	1	S.E.M.C	Iran			
F	12	Ex d IIB+H2 Emergency Stop, Mushroom Head, Stay pot (push & pull) Red (1NO+1NC) lockable			Iran			
<u>{</u>	13	Ammeter "Ziegler DE72" 0~125A/CT1A Class 1.5 (Equipped with red line & 6time )	1	Ziegler	German			
, }	14	Ammeter "Ziegler DE72" 0~20A/CT1A Class 1.5 (Equipped with red line & 6time)	5	Ziegler	German			
$ \geq $ [	15	LJB2 WINDOW TYPE EXD IIC T6	6	S.E.M.C	Iran			
(m)	 16	Terminal 2.5 mm <sup>2</sup>	162	RAAD	Iran			
	17	Terminal Green 2.5 mm <sup>2</sup>	201	RAAD	Iran			
-	18	Earth Terminal 2.5 mm <sup>2</sup>	9	RAAD	Iran			
	19	Ex d IIC Cable Gland M50-D Type 453 (Armoured) BOTTOM OF JB	4	S.E.M.C	Iran			
	20	Ex d IIC Plug M50 (Type 800) (Armoured) BOTTOM OF JB	3	S.E.M.C	Iran			
-	21	Ex d IIC Plug M40 (Type 800) BOTTOM OF JB	1	S.E.M.C	Iran			
	22	Ex d IIC Cable Gland M40-C2 Type 453 (Armoured) BOTTOM OF JB	1	S.E.M.C	Iran			
Ē	23	Ex d IIC Cable Gland M25-B Type VBL 453 (Armoured) BOTTOM OF JB	4	S.E.M.C	Iran			
$\left( \right)$	24	Ex d IIC Plug M25 (Type 800) FOR LJB2 WINDOW TYPE	6	S.E.M.C	Iran			
			+		$\rightarrow$			

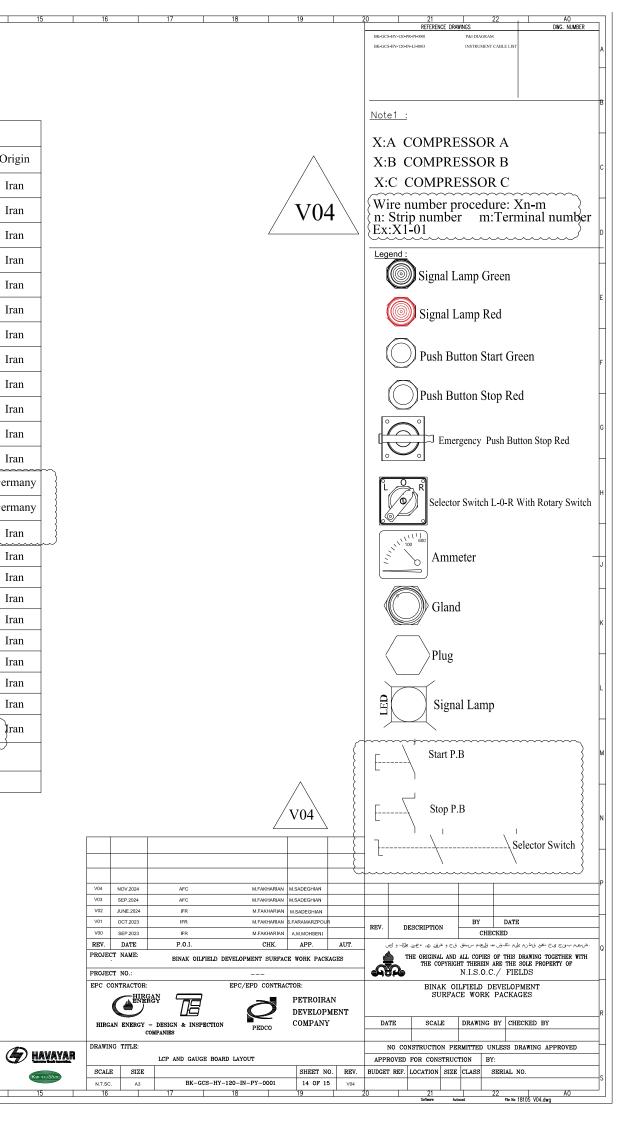

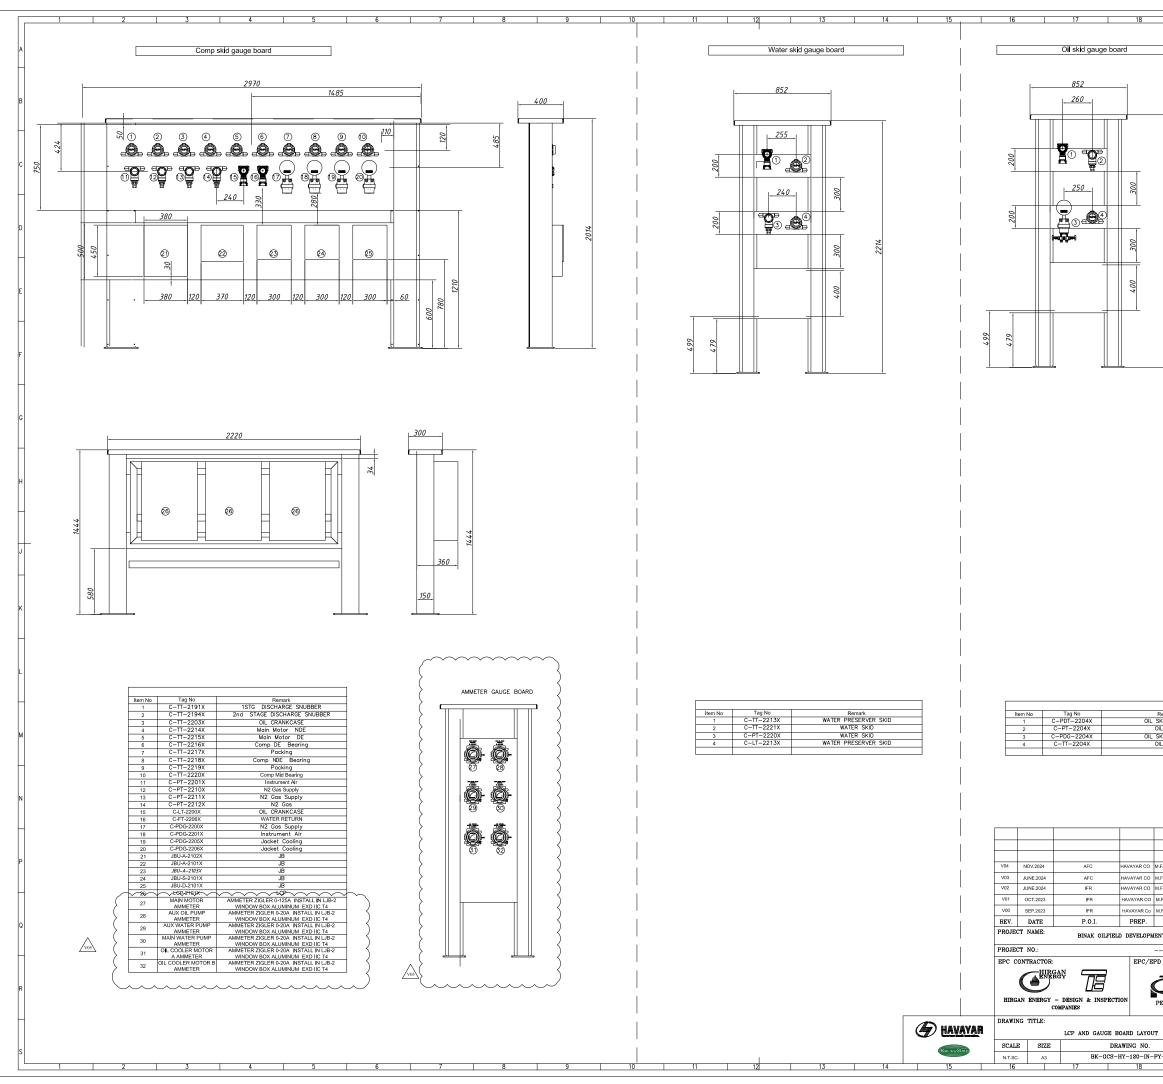

	19		20	21		22 A0	
				REFERENCE DRAW		DWG. NUMBER	
	,	8			&I DIAGRAM	NI SI INT	
	]	)	BK-GCS-HY	Y-120-IN-LL-0003 IN	STRUMENT CA		A
		$\sim$			~~~	~~~1	Ц
							в
							Н
							Ľ.
							Н
			Note	e1 :			
							D
2214			$\mathbf{v} \cdot \mathbf{v}$	A COMPRES	SOD	٨	
2							
			X:F	<b>B</b> COMPRES	SSOR	В	Н
			X:0	C COMPRES	SSOR	. C	F
							Ľ
							Н
							F
							Н
							-
			Lege	end :			ľ
							Η
							н
							Н
							Ш
							J
							Н
							к
							Π
							Ľ
		T					Н
emark		1					
KID FILTER L SKID		-					
KID FILTER		1					м
l skid		-					
		-					
							Π
							N
			1				Η
			1				
			L				P
FAKHARIAN	M.SADEGHIAN						
FAKHARIAN	M.SADEGHIAN						
FAKHARIAN	M.SADEGHIAN						Ц
	S.FARAMARZPOU	R	REV.	DESCRIPTION	BY	DATE	
FAKHARIAN	A.M.MOHSENI					CKED	
CHK.	APP.	AUT.	-	•		. هربیم باونج ژرخ طئ قطانم ولم نگارش به	Q
IT SURFAC	E WORK PACK	AGES		THE ORIGINAL AND THE COPYRICH	ALL COPIES T THEREIN	OF THIS DRAWING TOGETHER WITH ARE THE SOLE PROPERTY OF	
			କ୍ର			C./ FIELDS	
CONTRAC	TOR:					EVELOPMENT	+
	PETROIR	N		SURFAC	E WORK	PACKAGES	
$\rightarrow$	DEVELOP						
2	COMPANY		D.4	ATE SCALE	DRAWING	BY CHECKED BY	R
EDCO	COMPANI			SCALE	SPARING	S. CIMONED DI	+
			-	NO CONSTRUCTION DEE	יי תיוידיווא	NLESS DRAWING APPROVED	-
							-
	Grippin	0 131277		ROVED FOR CONSTRUCT T REF. LOCATION SIZE			+
-0001	SHEET N 15 OF 15		BUDGE	I REF. LOCATION SIZE	CLASS	SERIAL NO.	-s
		5 V04	1				
-0001	19		20	21		22 A0 File No 18105 V04.dwg	- 1