


LIGHTING FITTING	DESCRIPTION	LIGHTING FITTING	DESCRIPTION	LIGHTING FITTING

	LIGHTING FIXTURE — COMPACT FLUORESCENT LAMP — CELLING RECESSED MOUNTING TYPE WITH PLASTIC PRISMATIC DIFFUSER		- WALL MOUNTAIN TYPE - POLYCARDONATE CHEFUSOR	FOA AMEL PLUG FOR MENNEN 4 a New SCHEN NO 4

LIGHTING SCHEDULE



#	TYPE OF CABLE	CABLE TAG
1	3X2.5mm2, CU/PVC/PVC	a
2	3X4mm2, CU/PVC/PVC	ь
3	4X2.5mm2, CU/PVC/PVC	С

LIGHTING FIXTURE NUMBERING PROC

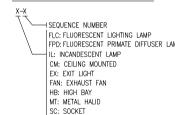

SP-SC: SPLIT SOCKET

						NOTES			
			_	1- 7-	HE MOLINTING HEIGHT		TINGS A	ROVE FINISH	FD FIONE
TY GUAF	RD F	ROOM		" "	HE MOUNTING HEIGHT EVEL SHALL BE AS FO SOCKET OUTLET (GE	DLLOWS:	At	FIRISH	LOOK
		1001		1 =	SOCKET OUTLET (GE SOCKET OUTLET (PA LIGHTING SWITCH =	NTRY)= 110	0 Cm		
G AREA				2- M	ETALLIC BODY OF ALL	. EQUIPMENT	SHOUL	D BE CONN	ECTED TO
				3- IN	DOOR DISTRIBUTION F	PANEL IS FL	USH MO	UNTED & IP	42
				4- B	ARTH SYSTEM. DOOR DISTRIBUTION F DITTOM POINT OF WAL BOVE FINISHED FLOOR	L MOUNTED	PANEL :	SHOULD BE	1.5m
				5- C	DADS (TDL) CONSIDER	CF) FOR CA	LOWS:	NG TOTAL D	EMANDED
				-	FOR LIGHTING CIRCL FOR SOCKET OUTLE ABLE ENTRY TO PANE	JIT CF=1 T = 0.5			
				6- C	ABLE ENTRY TO PANE IL CABLES SHALL BE	L IS FROM FIXED TO F	BOTTOM.	GLAND.	
				8- T	PE OF THE MINIATUR ARIOUS ELECTRICAL D S FOLLOW:	E CIRCUIT E	REAKER	FOR FEED	ING ARF
				~	S FOLLOW: LIGHTING: TYPE "R"	(MCB 10A)			
				=	UGHTING: TYPE "B" SOCKET: TYPE "C" SPILT SOCKET: TYPE	(MCB 16A) "C" (MCB	25A)		
				9-0	UTDOOR LIGHTING ARC	DUND BUILD	ING SHA	LL BE TURN	ED
				10- Th	n/off by Photoceli His drawing is valid Ells named as belo	FOR ALL 6	NUMBE	R OF	
				-	WELL NUMBER BK-1 WELL NUMBER BK-1	2 - Y	WELL NU	MBER BK-1 MBER W-00	4
		\wedge	~						
		/\	{	11-IND H	USTRIAL BUILDING LIC DG (HOT DIP GALVAN IRE SHALL BE LAID II POWER & CONTROL NIT & CONDENSER SI	HING CABL IZED) CONDU N PVC CONF	L SHALL JIT_AND JUIT	IN NON INC	USTRIAL
	,	/D01\	\ {	12-THE	POWER & CONTROL NIT & CONDENSER SI	CABLE BET	WEEN SI	PLIT BY VENDOR	
			<i>→</i>	<u> </u>		LEGEND		تست	
			\sim			~~~	~~~	~~~	~~~
			}		⊒	FALSE CEIL	LING. IPS	55	
			}		4X18 W RECESS 60X60 MODULAR	FALSE CEI	LING,BAT	TERY BACKU	P 30MIN.
			}	,					ii i oolk,
			}	EX	- WILL SO WILLOID	BUILT-IN E	BATTERY	PACK	
CABLE TAG			}	5	WALL MOUNTED COMPACT FLUOR	WITH GLASS ESCENT, IPS	UIFFUSE 55	IN FOR 18	**
a			}	T	EXHAUST FAN 4	OW			
ь			}		ONE POLE SWITCH	CH, ONE WAY	Y, 10A,	230V.	
С			}	م	2 WAY SWITCH, FLUSH MOUNTED	SINGLE POLI	E, 10A,	230V,	
EDURE			{	۱ × ۱	ONE POLE, MULT	TPOSITION S	WITCH,	10A, 230V,	
			{	🚡	ONE POLE, MULT FLUSH MOUNTED	, IF4∠ TIPOSITION S WATER PR	WITCH,	10A, 230V,	
			{	لـِ ا					
			}	Med.	SOCKET OUTLET 230V, 16A, FLUS SOCKET OUTLET	H MOUNTED	, IP42 H SINGI F	PHASE	
LAMP			{	\square	SOCKET OUTLET 230V, 16A, FLUS	H MOUNTED	, WATER	PROOF IPS	5
DIFFUSER L	AMP		}	ا	SOCKET OUTLET 230V, 25A, FLUS	(POWER) WI SH MOUNTED	ITH SING), IP42	LE POLE SV	MITCH
			}		ELECTRICAL DISTI WELL XX-DP02:	RIBUTION PA SECURITY B	NEL, IP4	2 DISTRIBUTIO	N PANEL
			}	ļπ	CU/PVC/PVC NO	RMAL LINE			
			}		— INDOOR UNIT WA — ■ INDOOR UNIT WA —				:
			}		OUTDOOR UNIT S		NOITION		
			{	<u> </u>	REFERENCE DRAW		-	DRG. N	
			{		L INSTALLATION DETILES & NOTES P			BK-CNRWL-PEDCO-	
			}		N NOTE FOR LICETING SYSTEM OF T RAC DEADTING FOR SECURENT BULLIN				
			{	and the FU		or week PASS -		www.rax0-1	u-u-u04
			~					~~~	~~~
				_		KEY PLAN			


H.SHAXIBA 3	LPAKHARIAN	M.WEHRSRAD	**,**			BY	DATE	BY	DATE
H.SHAXIBA 3	A.PAKHARIAN	N.MEHRSRAD	**,**	REV.	DESCRIPTION	CHEC			APPR.
	CHK.	APP.	AUT.	1 .3	ملی مناطق نفت خیز جنوب میباد ATR TRIBO OBJORNA SATO	, متعلق به شرکت . ۲۰ ت=CODID م	رحق اقتباس ۱۳ ۲۰۵۱۹ ت	ليه نسخ أين نقشه . PARTING TOUTON	اصلوگا uno wrw
DEVELOPMENT/SUE GENERA		. WOR PAC		ړ	THE ORIGINAL AND THE COPYRIGI	HT THEREIN A	RETHES	OLE PROPERTY	OF
971020		n (aa)		646	7 19	N.I.S.O.C.	/ FIEL	אמ	

	T														
	T														
	T								*********		***,****	**,**	,		
D01	T	OCT.2022	IPA	H.SHAKIBA	M.PAKHARIAN	M.MEHRSHAD	***	REV.	DESCRIPTION	BY	DATE	BY	DATE		
D00	T	¥AY.2022	IPC	H.SHAKIBA	M.PAKHARIAN	M.MEHRSHAD	**.**	KEV.	DESCRIPTION	CHE	CKED	REV.	APPR.		
REV.	T	DATE	P.O.I.S	PREP.	CHK.	APP.	AUT.	-4	ملى مناطق نفت خيز جنوب ميباث	ىتعلق بە ئىرگت	ه و حق اقتباس ،	ليه نـخ اين نقث	اصل و ک		
PROJECT	PROJECT NAME: BINAK OILFIELD DEVELOPMENT/SUB-SURFACE WORK PACKAGES GENERAL						CKAGES	THE ORIGINAL AND ALL COPIES OF THIS DRAWING TOGETHER WITH THE COPYRIGHT THEREIN ARE THE SOLE PROPERTY OF							
PROJECT	2	τφ. :		9710	20			44	P	N.I.S.O.C	./ FIELD	S			

EPD/EPC CONTRACTOR (GC): PETROIRAN DEVELOPMENT COMPANY PEDCO


BINAK OILFIELD DEVELOPMENT SUB-SURFACE WORK PACKAGES SCALE DRAWING BY CHECKED BY PROJECT ENG.

ORAWING TITLE:
LIGHTING & SMALL POWER LAYOUT FOR SECURITY BUILDING OF
WELL PADS APPROVED FOR CONSTRUCTION BY: SCALE SIZE SHEET NO. REV. BUDGET REF. LOCATION SIZE CLASS SERIAL NO. SHEET REVISION DRAWING NO. AS SHOWN A3 BK-SSGRL-PEDCO-110-EL-PY-0005 2 OF 3 D01 053-073-9184 F 2 P 707413 2 OF 3 D01

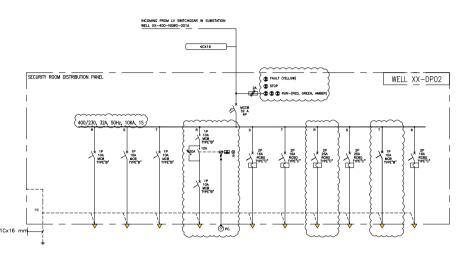

FEEDER ID	INCOMING	F1	F2	F3	F4	F5	F6	F7	F8	F9	F10
LINE	L1, L2, L3	~	L2	L3	L1	} }⊾	L3	\	¹²	L3	L1
DEMAND LOAD	9.910 KW	88 W	144 W	58 W	120 W	1500 W	2000 W	3000 W	3000 W	} -	-
CONSUMER LOAD (W)	-	1NO. FLC 2NO. EXIT	2NO. FLC	1NO. CM 1NO. FAN	6NO. IL	3NO. SC	4NO. SC	SPLIT	SPLIT	SPARE	SPARE
CABLE/ SIZE-TYPE	CU/XLPE/SWA/PVC 4CX16	CU/PVC/PVC 3X2.5	CU/PVC/PVC 3X2.5	CU/PVC/PVC 3X2.5	CU/PVC/PVC 3X2.5	CU/PVC/PVC 3X4	CU/PVC/PVC 3X4	CU/PVC/PVC 3X4	CU/PVC/PVC 3X4	-	-

SHEET THICKNESS	2 mm	
COLOR	RAL 7032	
ACCESSIBILITY	FRONT	
INC CONNECTION	воттом	
OUT CONNECTIONS	BOTTOM	
INSTALLATION TYPE	FLUSH MOUNTED	}
IP CODE	IP 42	Γ

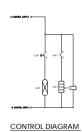

NOTES 1- PANEL SHALL BE WALL FLUSH MOUNTED TYPE. CENTER POINT OF THIS PANEL SHOULD BE 1.5m ABOVE FINISHED FLOOR - INCOMING CABLE SIZE SHALL BE SELECTED ACC. TO THE LATEST REVISION OF CALCULATION NOTE FOR CABLE SIZING OF WELL PADS (BK-SSGRL-PEDCO-110-EL-CN-0005). - INCOMING FEEDER SHALL BE PROVIDED WITH CURRENT LIMITTING SYSTEM. THE POWER DEMAND OF EACH FEEDER HAS BEEN CALCULATED BASED ON BELOW ASSUMPTION: D01 - FOR LIGHTING ALL CONNECTED FIXTURES HAS BEEN CONSIDERED ON. FOR SOCKET ALL CONNECTED OUTLET HAS BEEN CONSIDERED SOOW WITH CF=0.5
 FOR EXAMPLE ON FEEDER F5, THERE ARE 4 OUTLET SOCKET THE POWER IS 2000W BUT WITH CE=0.5 IS WILL BE 1000W THIS SLD IS VALID FOR ALL 6 NUMBER OF SECURITY BUILDING PANEL FOR WELLS NAMED AS BELOW: - WELL NUMBER BK-12 - WELL NUMBER BK-15 - WELL NUMBER BK-05 - WELL NUMBER BK-14 - WELL NUMBER W-007 - WELL NUMBER W-046 LEGEND AUTOMATIC CIRCUIT BREAKER MCCB WITH THERMAL MAGNET 4 POLE MINIATURE CIRCUIT BREAKER RCBO, RESIDUAL CIRCUIT BREAKER WITH OVER CURRENT PROTECTION ∅ PHOTO CELL FUSE SIGNAL LAMP ROTARY SWITCH D01\ TYPICAL INSTALLATION DETAILS & NOTES FOR LIGHTING SYSTEM BK-GARAL-PEDICO-600-EL-DW-6003 TURN, DENTING FOR SECURETY BUILDING OF WELL PAINS - WOMES - MY-MOMES-PROCE-110-48-DV-0004 KEY PLAN H.SHAKIBA M.PAKHARIAN M.MEHRSHAD **.** BY DATE BY DATE REV. DESCRIPTION H.SHAKIBA M.PAKHARIAN M.MEHRSHAD CHECKED REV. APPR. PREP. CHK. APP. AUT. اصل و کلیه نسخ این نقشه و حق اقتباس متعلق به شرکت ملی مناطق نفت خیز جنوب میباشد. THE ORIGINAL AND ALL COPIES OF THIS DRAWING TOGETHER WITH THE COPYRIGHT THEREIN ARE THE SOLE PROPERTY OF N.I.S.O.C./ FIELDS 971020

D01 OCT.2022 D00 MAY.2022 IFC REV. DATE P.O.I.S PROJECT NAME: BINAK OILFIELD DEVELOPMENT/SUB-SURFACE WORK PACKAGES
GENERAL PROJECT NO.: EPC CONTRACTOR: EPD/EPC CONTRACTOR (GC): BINAK OILFIELD DEVELOPMENT SUB-SURFACE WORK PACKAGES T PETROIRAN

(VENDOR TITLE BLOCK)**

DRAWING LIGHT		SMALL POWER LAYO	NO CONSTRUCTION PERMITTED UNLESS DRAWING APPROVED									
Ladii	ind a		PADS	OI .	APPROVED FOR CONSTRUCTION BY:			BY: DATE:				
SCALE	SIZE	DRAWIN	NG NO.	SHEET NO.	REV.	BUDGET REF.	LOCATION	SIZE	CLASS	SERIAL NO	. SHEET	REVISION
AS SHOWN	A3	BK-SSGRL-PEDCO	-110-EL-PY-0005	3 OF 3	D01	053-073-9184	F	2	P	707413	3 OF	3 DO1

DEVELOPMENT

COMPANY

DATE

SCALE DRAWING BY CHECKED BY PROJECT ENG.