

DOCUMENT TITLE:
ESD BLOCK DIAGRAM




NOTES

LEGEND

REFERENCE DRAWING

DRG. No.



KEY PLAN

D02	OCT.2023	APC	M.Aryador	M.PAKHSHAN	S.PAKHSHANPOUR	**_**	***	*****	**_**	***_****	**_**	***_****						
D01	DEC.2022	IFA	M.Aryador	M.PAKHSHAN	M.MEHRSHAD	**_**	REV.	DESCRIPTION	BY	DATE	BY	DATE						
D00	MAY.2022	IPC	M.Aryador	M.PAKHSHAN	M.MEHRSHAD	**_**					CHECKED		REV.	APPR.				
REV.	DATE	P.O.I.S	PREP.	CHK.	APP.	AUT.	اشاره و کلیه نسخ این نقشه و جزئیات متعلق به شرکت ملی مناطق نفت خیز جنوب میباشد. THE ORIGINAL AND ALL COPIES OF THIS DRAWING TOGETHER WITH THE COPYRIGHT THEREIN ARE THE SOLE PROPERTY OF N.I.S.O.C./ FIELDS											
PROJECT NAME:						BINAK OILFIELD DEVELOPMENT/SURFACE FACILITIES GAS COMPRESSOR STATION												
PROJECT NO.:						971020												
EPC CONTRACTOR:			EPD/EPC CONTRACTOR (GC):						BINAK OILFIELD DEVELOPMENT SURFACE FACILITIES GAS COMPRESSOR STATION									
 HIRGAN ENERGY - DESIGN & INSPECTION COMPANIES			 PEDCO			PETROIRAN DEVELOPMENT COMPANY												
									DATE	SCALE	DRAWING BY	CHECKED BY	PROJECT ENG.					
DRAWING TITLE:						NO CONSTRUCTION PERMITTED UNLESS DRAWING APPROVED												
ESD BLOCK DIAGRAM																		
SCALE		SIZE	DRAWING NO.			SHEET NO.	REV.	BUDGET REF.	LOCATION	SIZE	CLASS	SERIAL NO.	SHEET	REVISION				
N.T.S		A3	BK-GCS-PEDCO-120-PR-BD-0001			1 OF 7	D02	00-63-073-9184	F	2	J	708804	07	D02				

(VENDOR TITLE BLOCK)**

ESD 0

Total Emergency Shutdown
With Depressurizing

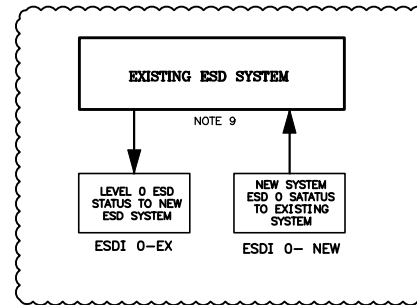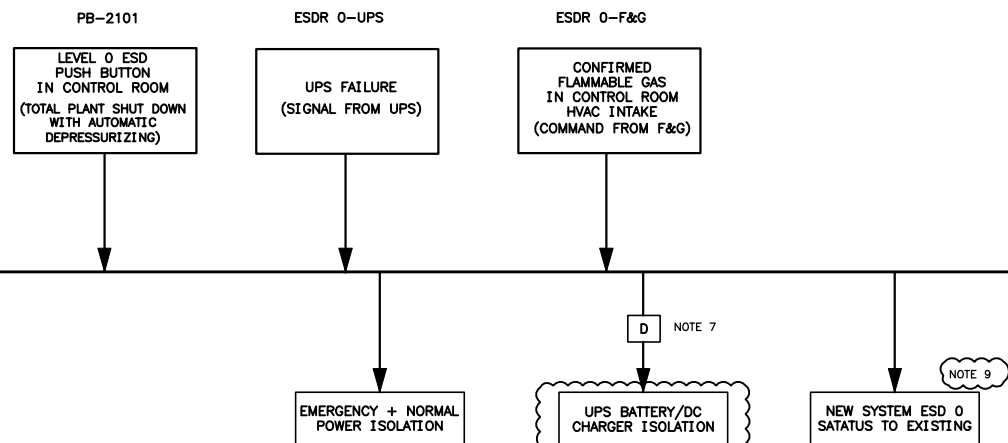

- NOTES**
1. THE UPS SHALL GENERATE AN ALARM BEFORE POWER LOSS TO NOTIFY OPERATOR. THE OPERATOR SHALL TAKE NECESSARY ACTIONS BEFORE LOOSING THE SAFETY SYSTEM FOR SAFE SHUTDOWN AND BLOWDOWN OF PLANT.
 2. BLOWDOWN COMMAND SHALL BE GENERATED AFTER PRE-DEFINED TIME (ACCORDING TO ESD PHILOSOPHY) OR IN CASE OF RECEIVING RELATED ESDVs CLOSED STATUS SIGNAL.
 3. TO BE CONSIDERED IN F&G CAUSE & EFFECT.
 4. ALL ELECTRICAL SOURCES EXCEPT ESSENTIAL POWER SOURCES SHALL BE ISOLATED
 5. KEY PROTECTED PUSHBUTTONS SHALL BE PROVIDED FOR BLOWDOWN OF EACH TRAIN BY RECEIVING THE PERMISSION FROM ESD SYSTEM. THE KEY SHALL ACTIVATE STAGE BLOWDOWN VALVES INCLUDING THE TRAINS.
 6. FOR DETAILS OF ESD 3 CAUSES AND EFFECTS, REFER TO CAUSE & EFFECT DIAGRAM.
 7. ADJUSTABLE DELAY.
 8. LEVEL 0 ESD FROM EXISTING ESD SYSTEM SHALL GENERATE AN ALARM AND SHALL NOT HAD ANY EFFECT IN THIS ESD SYSTEM. BECAUSE THE NEW AND EXISTING PARTS ARE SEPARATE AND HAVE ISOLATE INPUT AND OUTPUT LINES.
 9. LEVEL 0 ESD FROM EXISTING ESD SYSTEM SHALL GENERATE AN ALARM AND SHALL NOT HAVE ANY EFFECT IN THIS ESD SYSTEM. BECAUSE THE NEW AND EXISTING PARTS ARE SEPARATE AND HAVE ISOLATE INPUT AND OUTPUT LINES.
 10. FLARE SHALL OPERATE SMOKE FREE UNDER NORMAL OPERATION CONDITION AS WELL AS UNDER EMERGENCY CONDITION SO AIR BLOWER SHALL START FOR BOTH CONDITION.

LEGEND

I.A. Instrument Air
PA/GA Public Address/General Alarm
K.O. Knock-out Drum
H.H. High High
L.L. Low Low
P.B. Push Button
ESDV Emergency Shutdown Valve
BDV Blow-Down Valve


REFERENCE DRAWING

DRG. No.

KEY PLAN

ESD 1

Process Emergency Shutdown
(without Depressurizing)

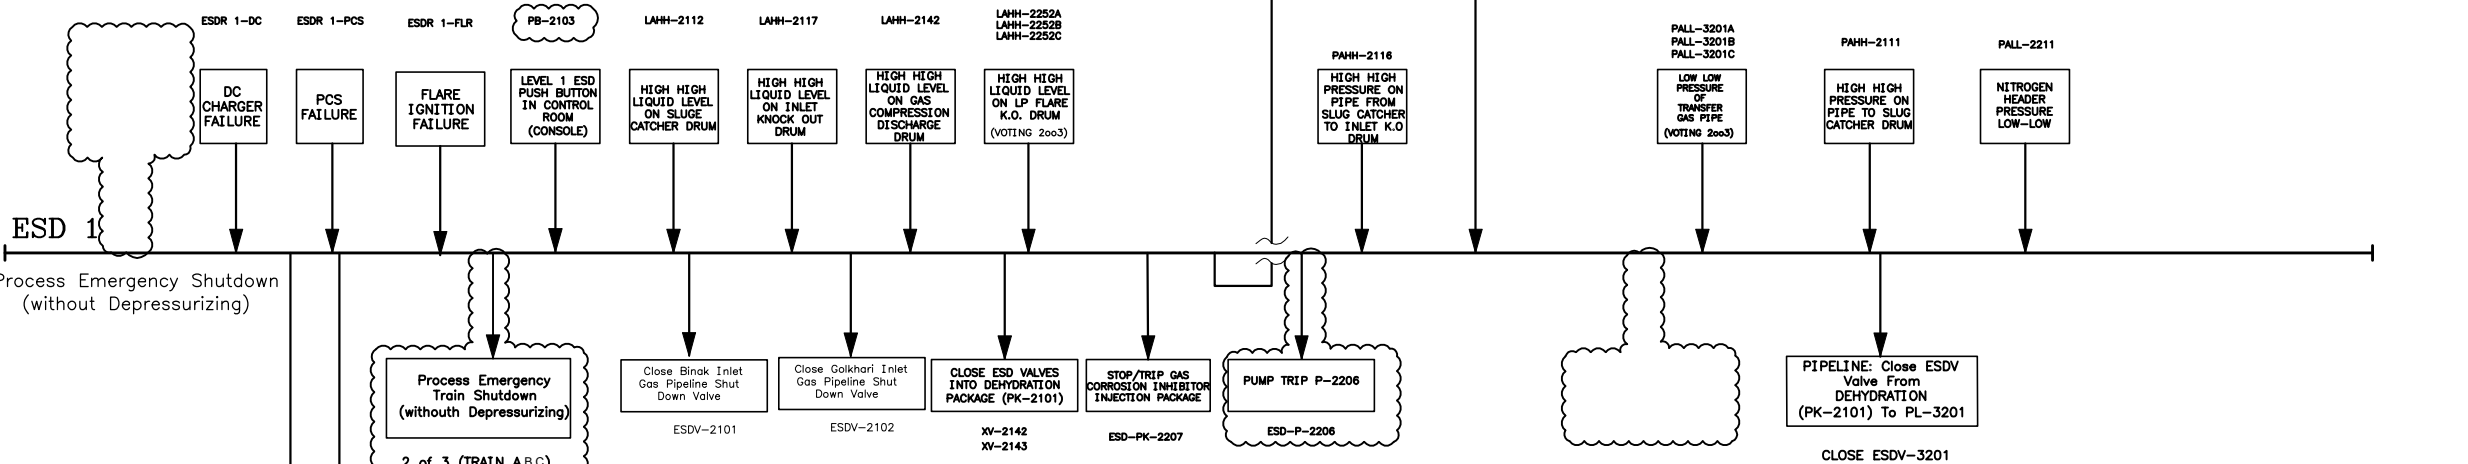


ESD 2

ESD 3

--	--	

(VENDOR TITLE BLOCK)**

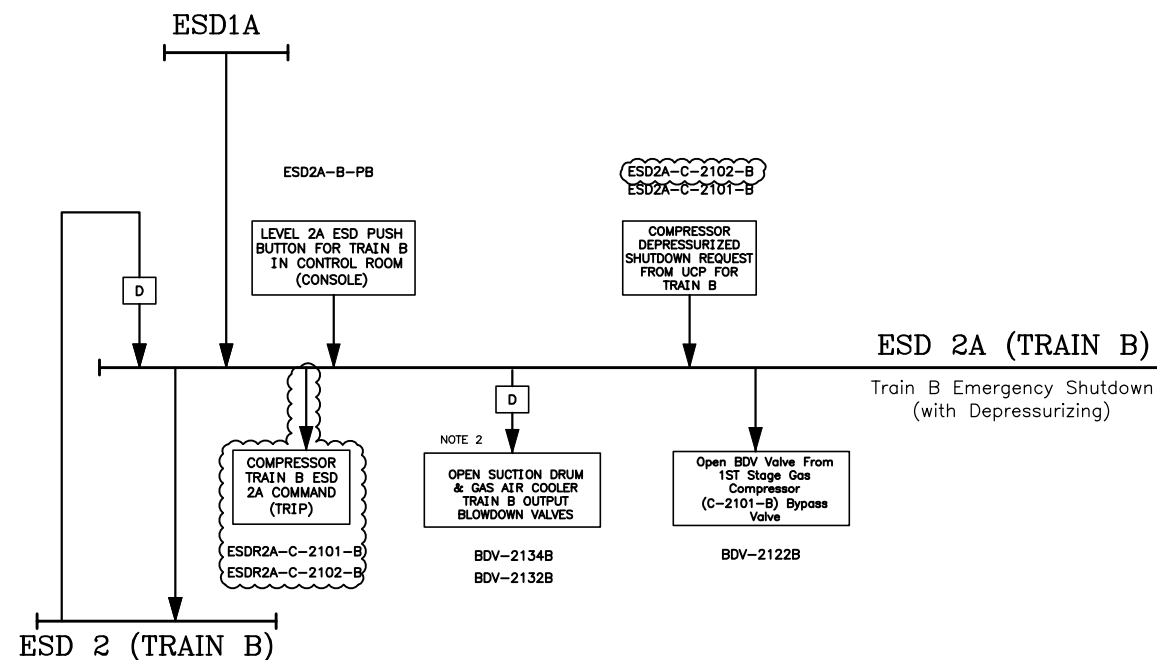

NOTES

1. THE UPS SHALL GENERATE AN ALARM BEFORE POWER LOSS TO NOTIFY OPERATOR. THE OPERATOR SHALL TAKE NECESSARY ACTIONS BEFORE LOSING THE SAFETY SYSTEM FOR SAFE SHUTDOWN AND BLOWDOWN OF PLANT.
2. BLOWDOWN COMMAND SHALL BE GENERATED AFTER PRE-DEFINED TIME (ACCORDING TO ESD PHILOSOPHY) OR IN CASE OF RECEIVING RELATED ESDVS CLOSED STATUS SIGNAL.
3. TO BE CONSIDERED IN F&G CAUSE & EFFECT.
4. ALL ELECTRICAL SOURCES EXCEPT ESSENTIAL POWER SOURCES SHALL BE ISOLATED
5. KEY PROTECTED PUSHBUTTONS SHALL BE PROVIDED FOR BLOWDOWN OF EACH TRAIN BY RECEIVING THE PERMISSION FROM ESD SYSTEM. THE KEY SHALL ACTIVATE STAGE BLOWDOWN VALVES INCLUDING THE TRAINS.
6. FOR DETAILS OF ESD 3 CAUSES AND EFFECTS, REFER TO CAUSE & EFFECT DIAGRAM.
7. ADJUSTABLE DELAY.
8. ALL ESDVS SHALL BE CLOSED EXCEPT ESDVS IN FLARE K.O. DRUM LIQUID DISCHARGE LINE.

LEGEND	
I.A.	Instrument Air
PA/GA	Public Address/General Alarm
K.O.	Knock-out Drum
H.H.	High High
L.L.	Low Low
P.B.	Push Button
ESDV	Emergency Shutdown Valve
BDV	Blow-Down Valve


REFERENCE DRAWING	DRG. No.
*****	*****




















[illegible]

KEY PLAN




























[illegible]

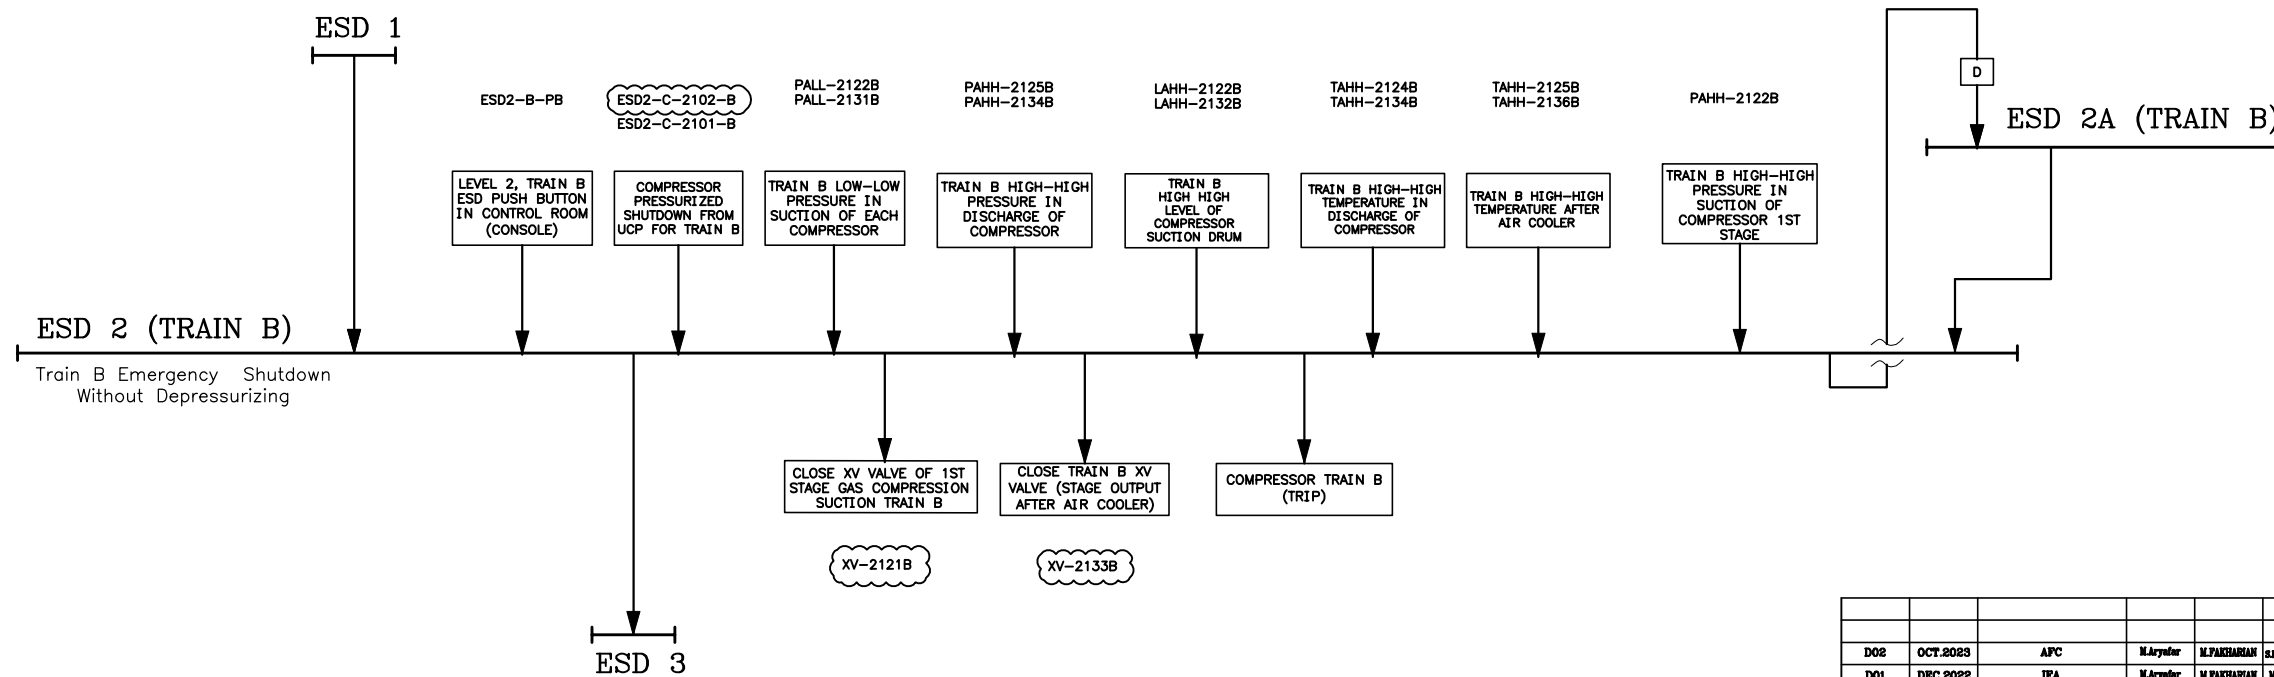[illegible]

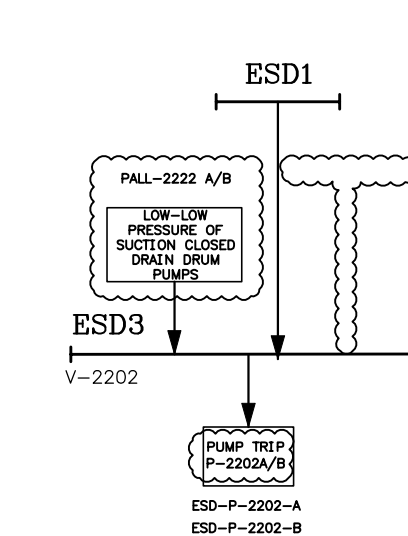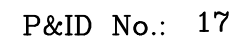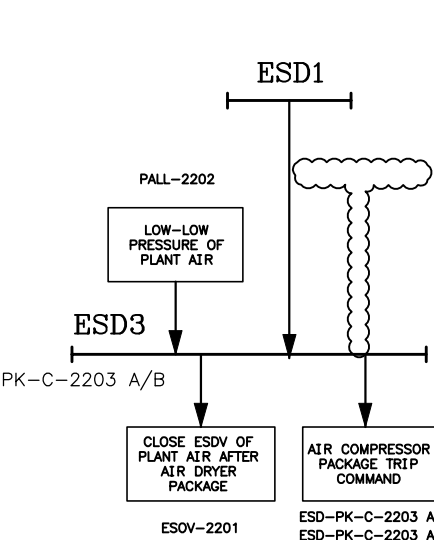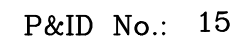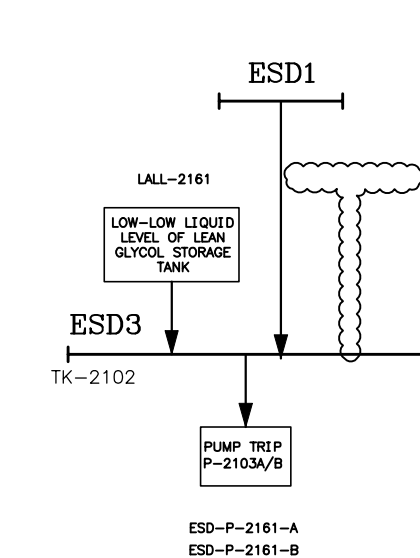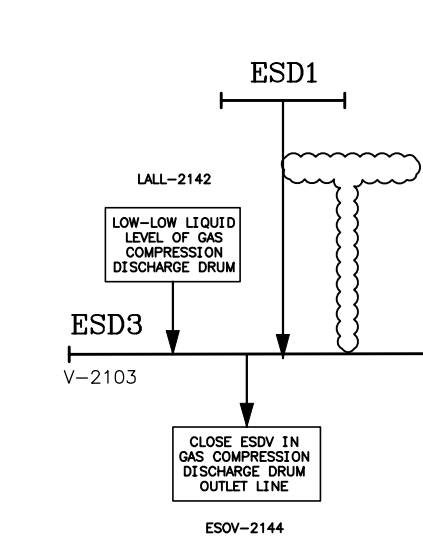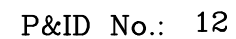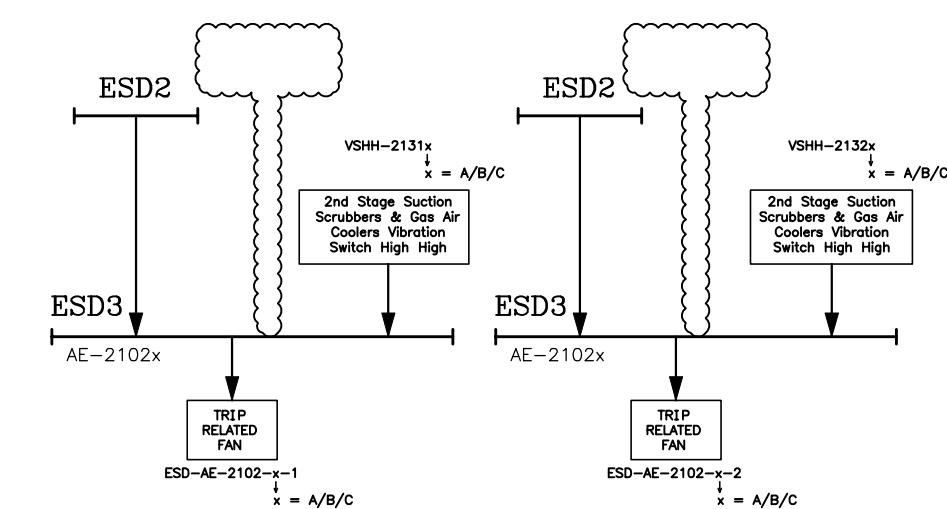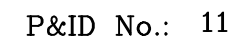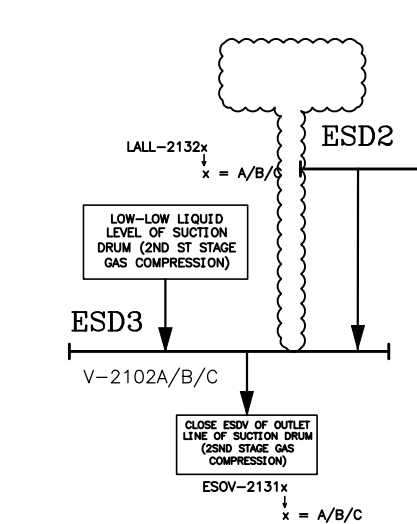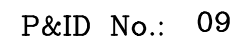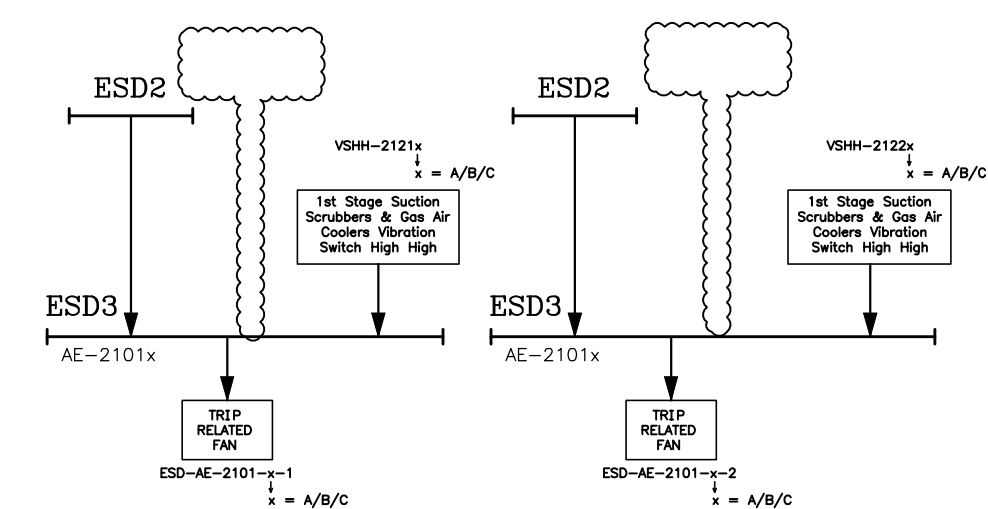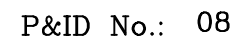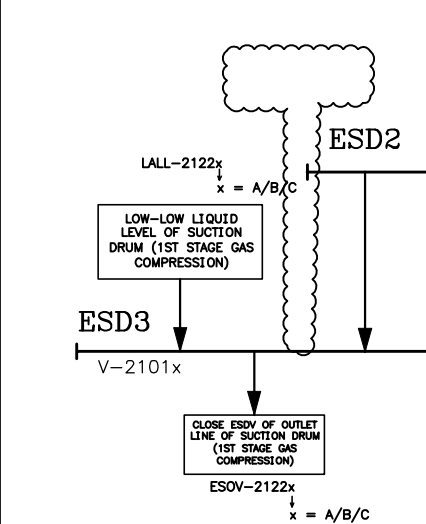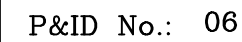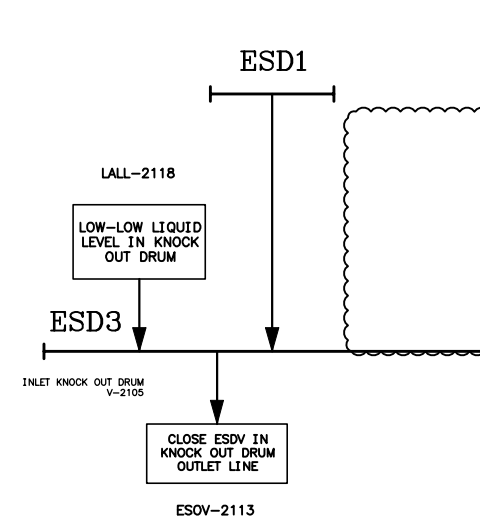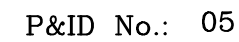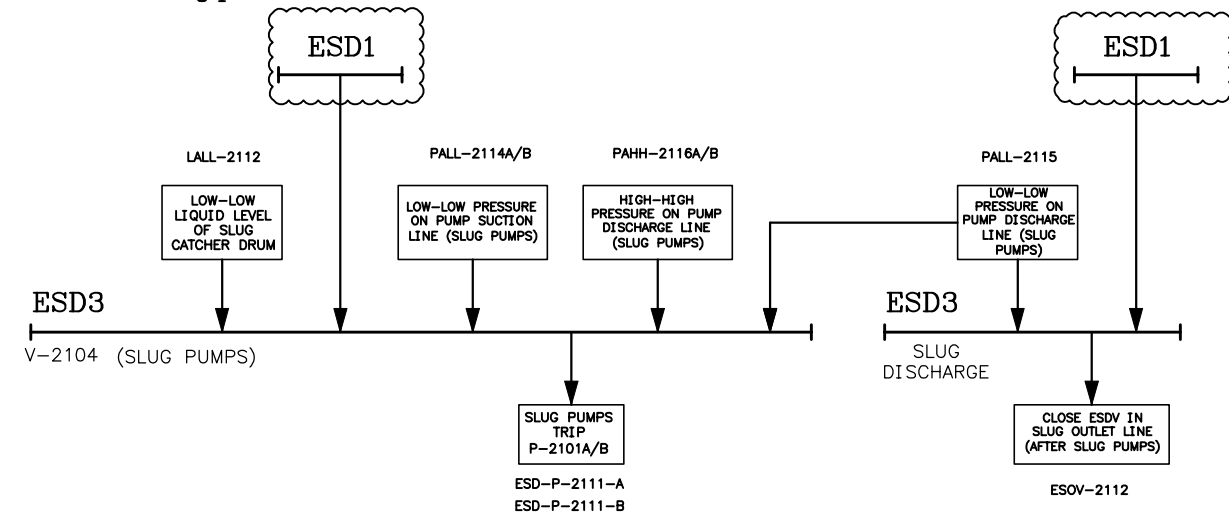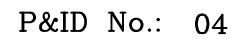

NOTES






LEGEND

I.A.	Instrument Air
PA/GA	Public Address/General Alarm
K.O.	Knock-out Drum
H.H.	High High
L.L.	Low Low
P.B.	Push Button
ESDV	Emergency Shutdown Valve
BDV	Blow-Down Valve

REFERENCE DRAWING	DRG. No.
*****	*****

KEY PLAN

[illegible]

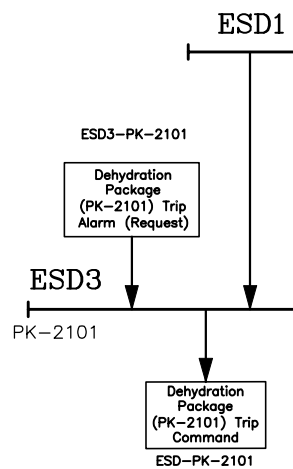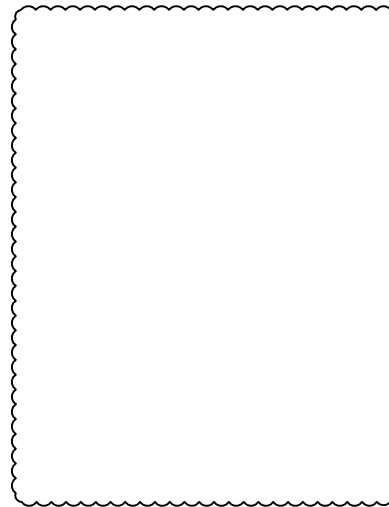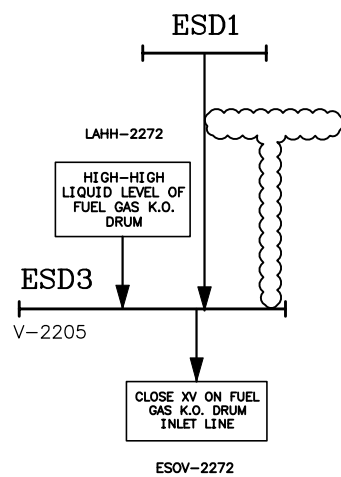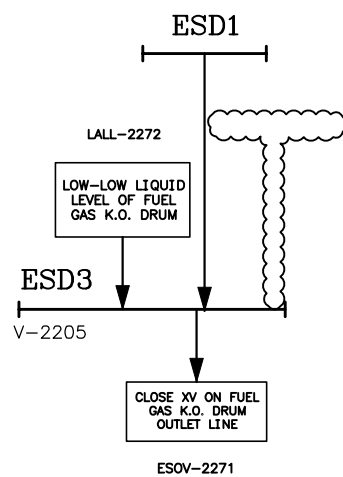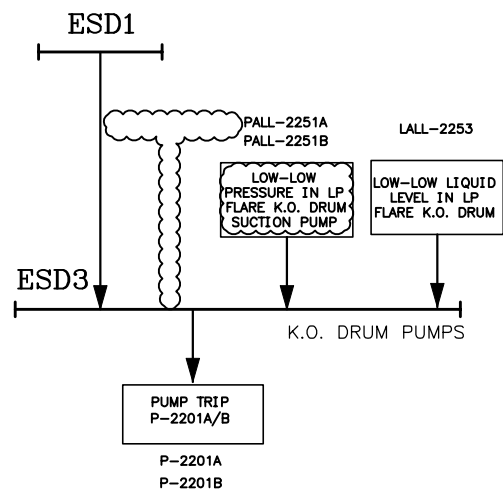

NOTES	

LEGEND	
I.A.	Instrument Air
PA/GA	Public Address/General Alarm
K.O.	Knock-out Drum
H.H.	High High
L.L.	Low Low
P.B.	Push Button
ESDV	Emergency Shutdown Valve
BDV	Blow-Down Valve

REFERENCE DRAWING	DRG. No.
*****	*****

KEY PLAN

[illegible]