


LCP COMPRESSOR

Enclosure Specification

Tag number

LCP-2101X (Note 1)

Marking acc to 94/9/EC directive



II 2 G D

Marking acc. to IEC

Ex d IIB+H2 T4

Ingress Protection to IEC 60529

IP66

Permissible Ambient Temperature

5 °C TO 55° C

Material

Copper Free Aluminium


Colour Of Enclosure


RAL 7035

Thickness

20mm±5mm

[illegible]

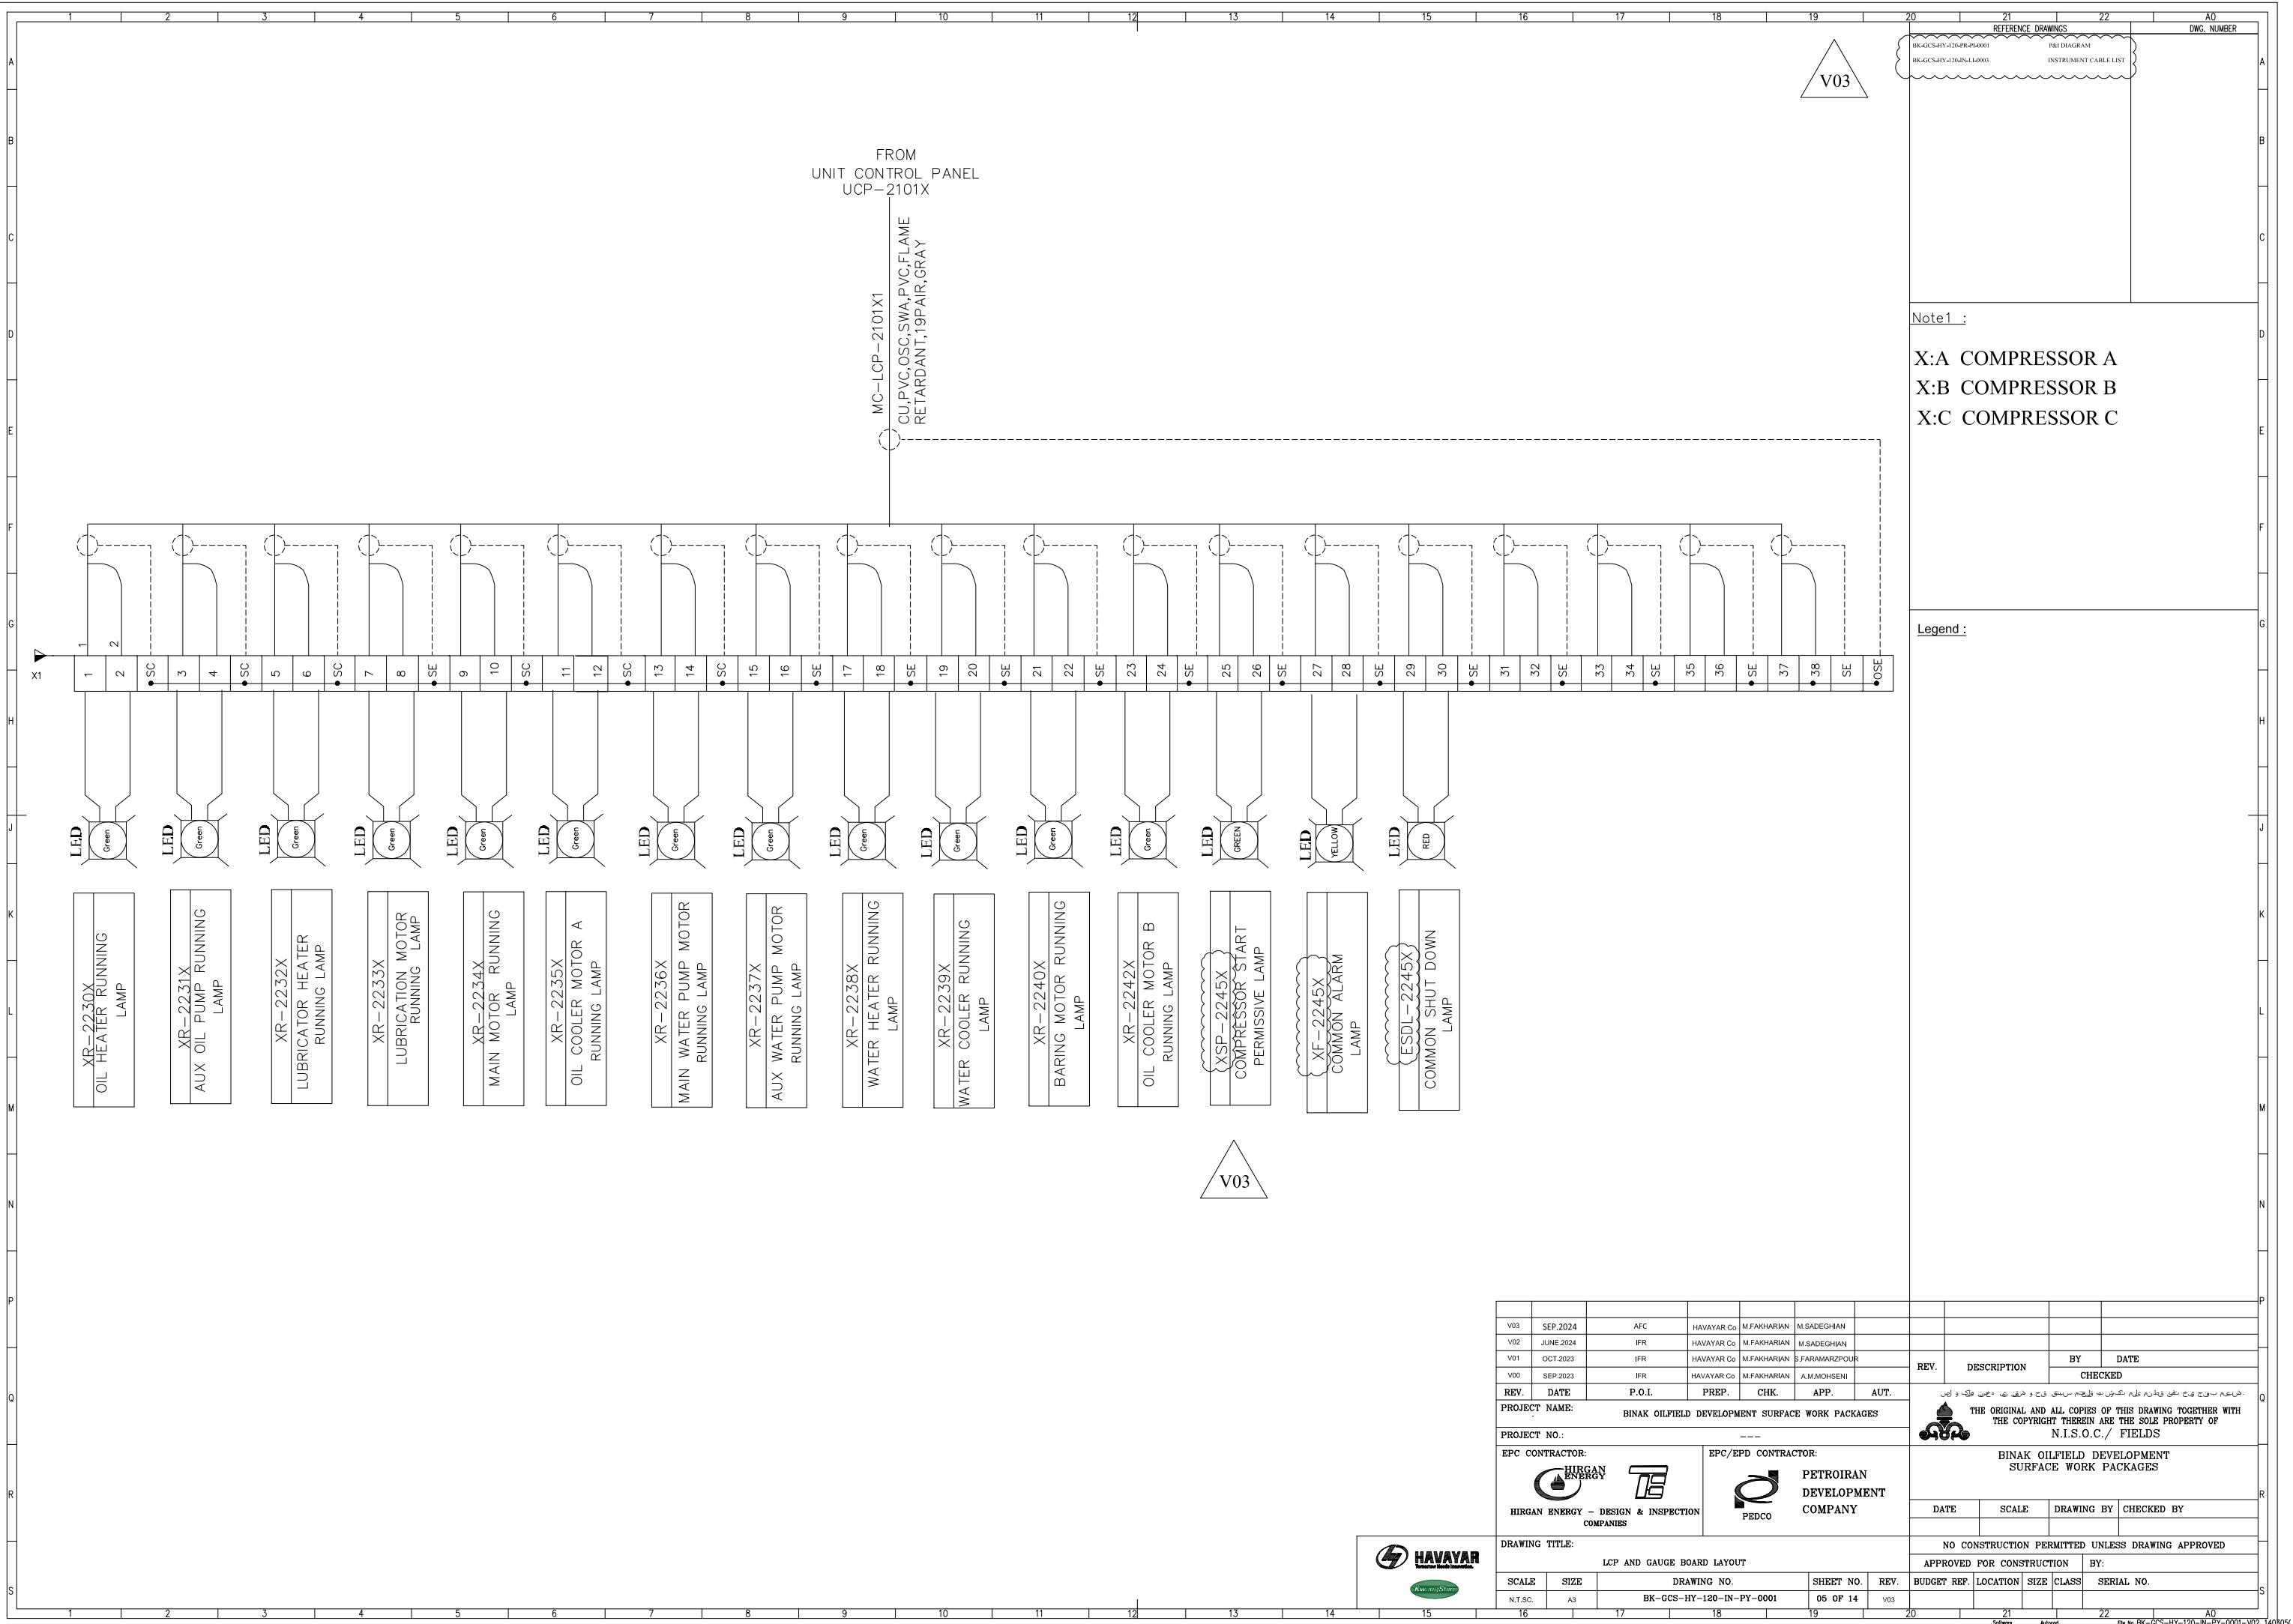

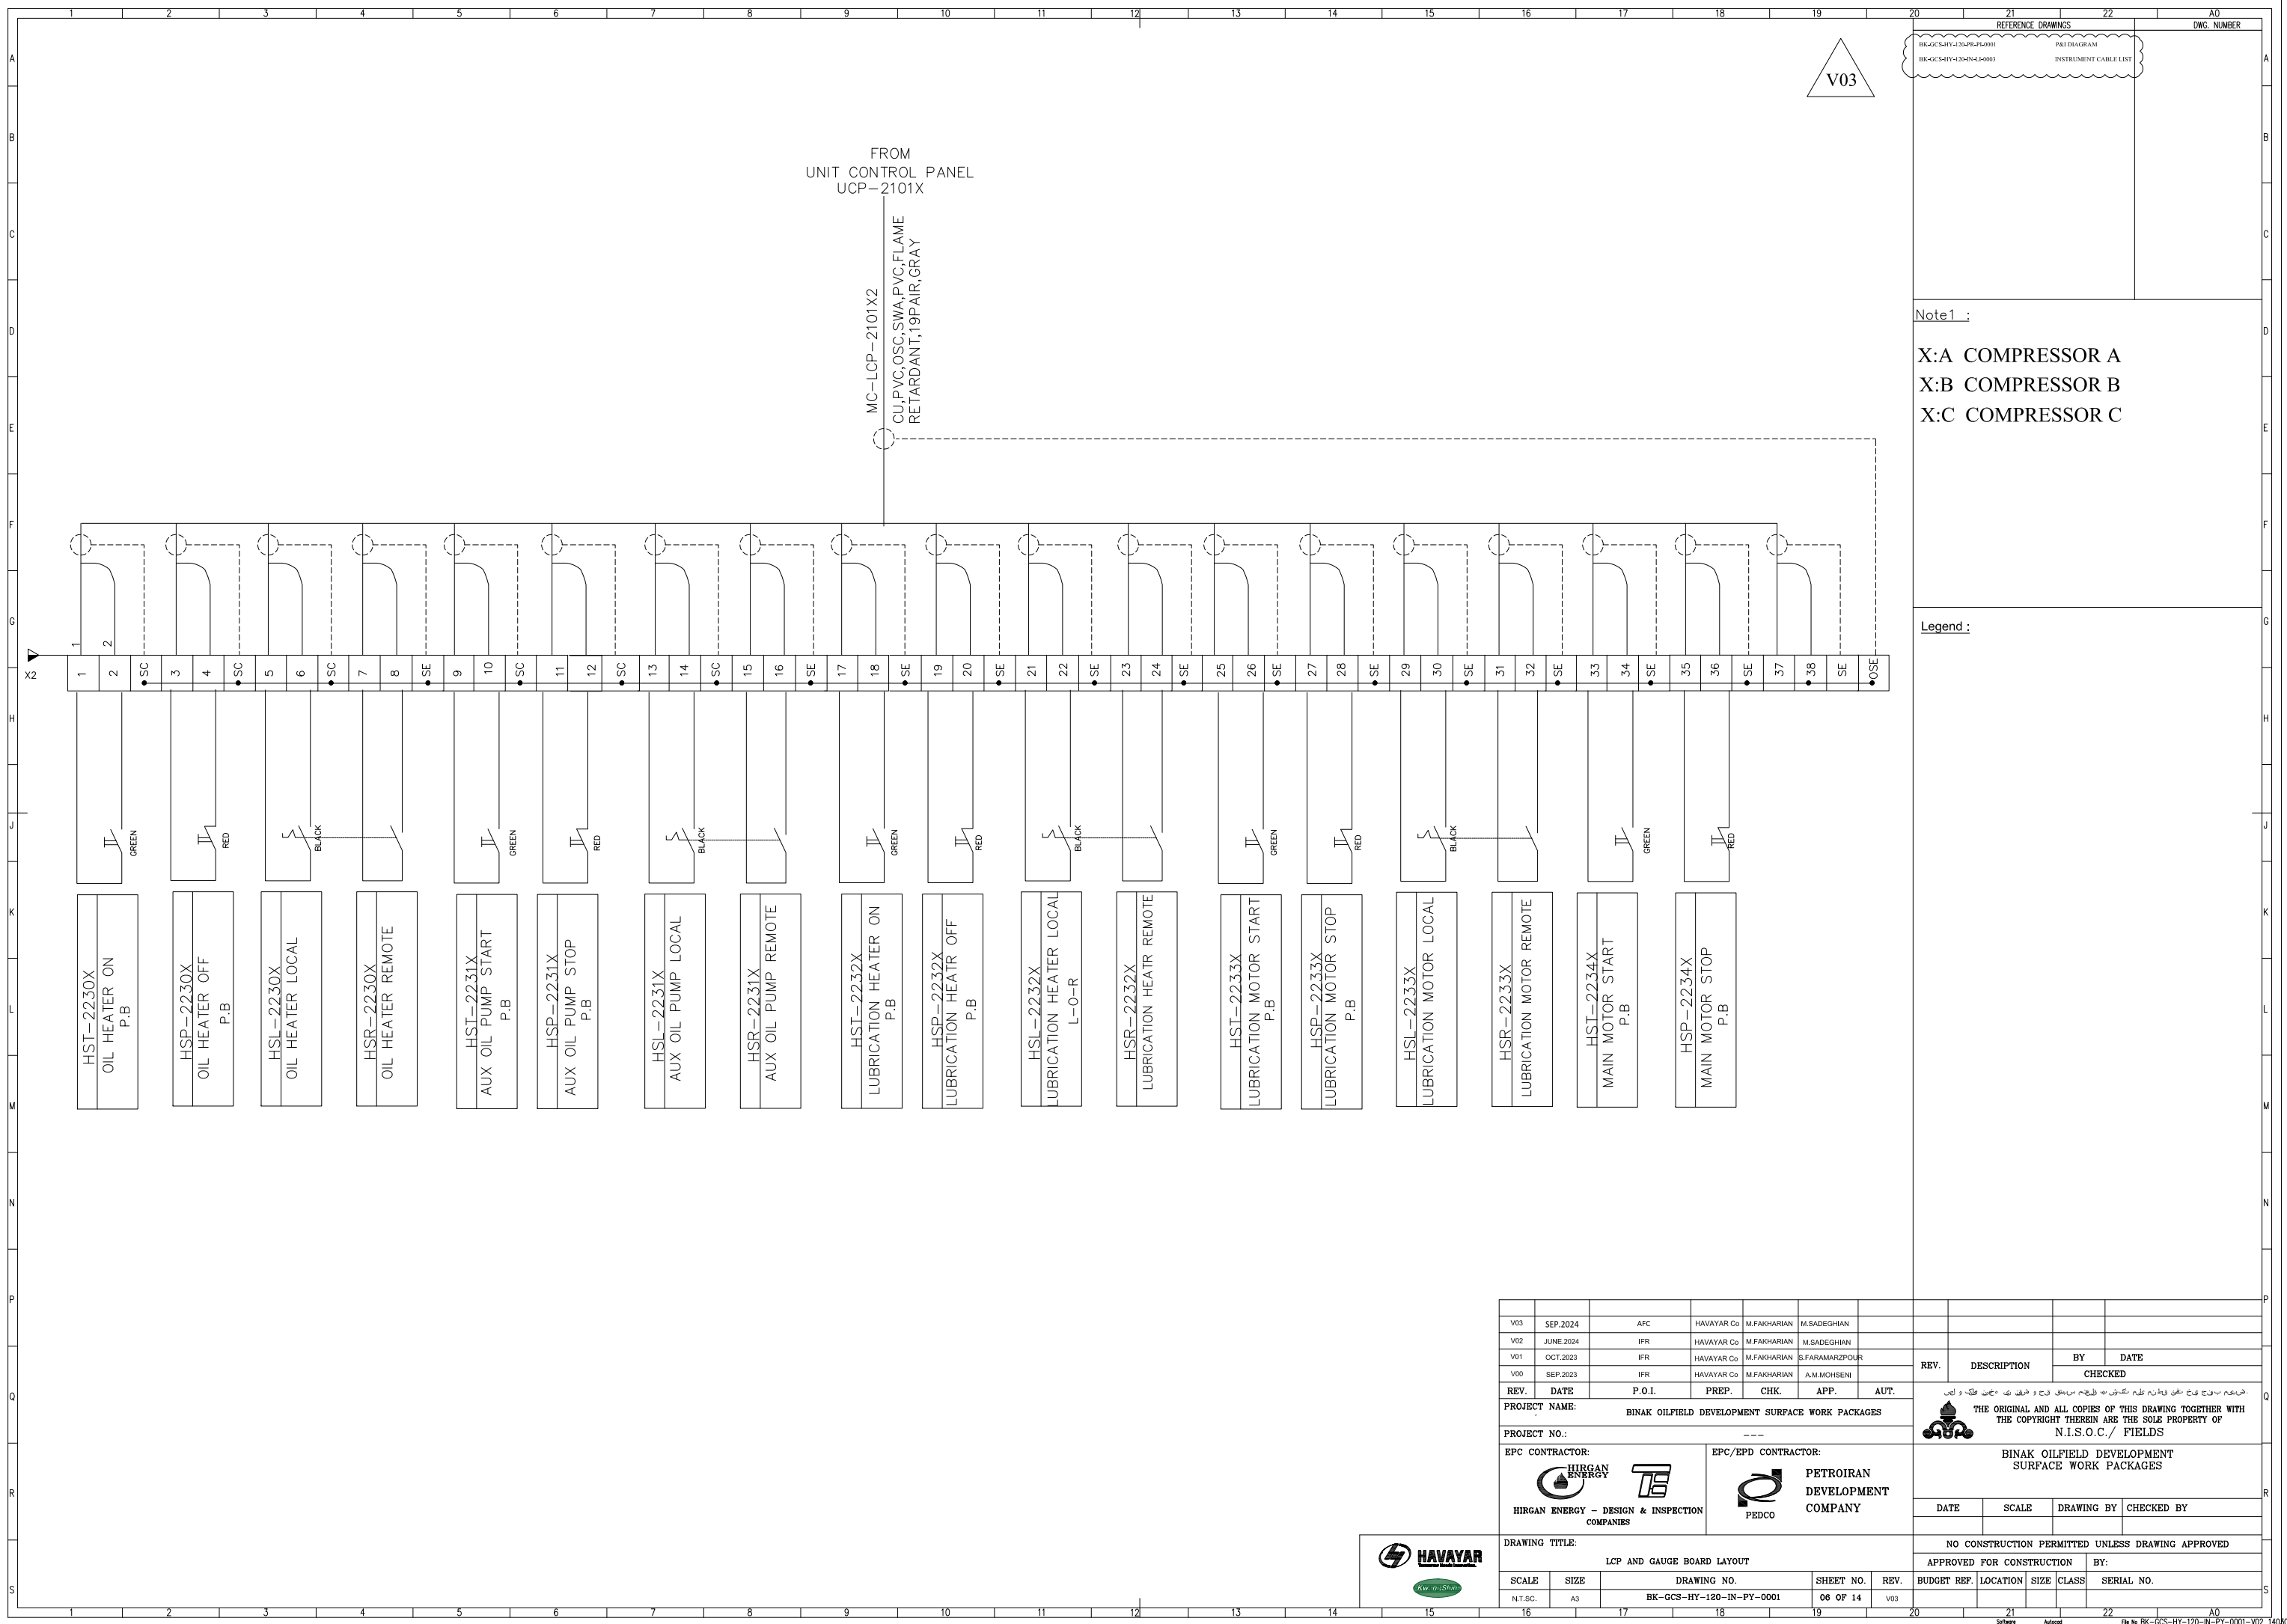

FROM BOX 1

TO BOX 3

V03

V03

V03

External Earth Lug M8

Note1 :

X:A COMPRESSOR A
X:B COMPRESSOR B
X:C COMPRESSOR C

Legend :

- Signal Lamp Green
- Signal Lamp Red
- Push Button Start Green
- Push Button Stop Red
- Emergency Push Button Stop Red
- Selector Switch L-0-R With Rotary Switch
- Ammeter
- Gland
- Plug

| |
|---|
| V03 | SEP.2024 | AFC | HAVAYAR Co | M.FAKHARIAN | M.SADEGHIAN | |</ |
|---|

THE ORIGINAL AND ALL COPIES OF THIS DRAWING TOGETHER WITH THE COPYRIGHT THEREIN ARE THE SOLE PROPERTY OF N.I.S.O.C./ FIELDS


DATE SCALE DRAWING BY CHECKED BY

NO CONSTRUCTION PERMITTED UNLESS DRAWING APPROVED

APPROVED FOR CONSTRUCTION BY:

BUDGET REF. LOCATION SIZE CLASS SERIAL NO.



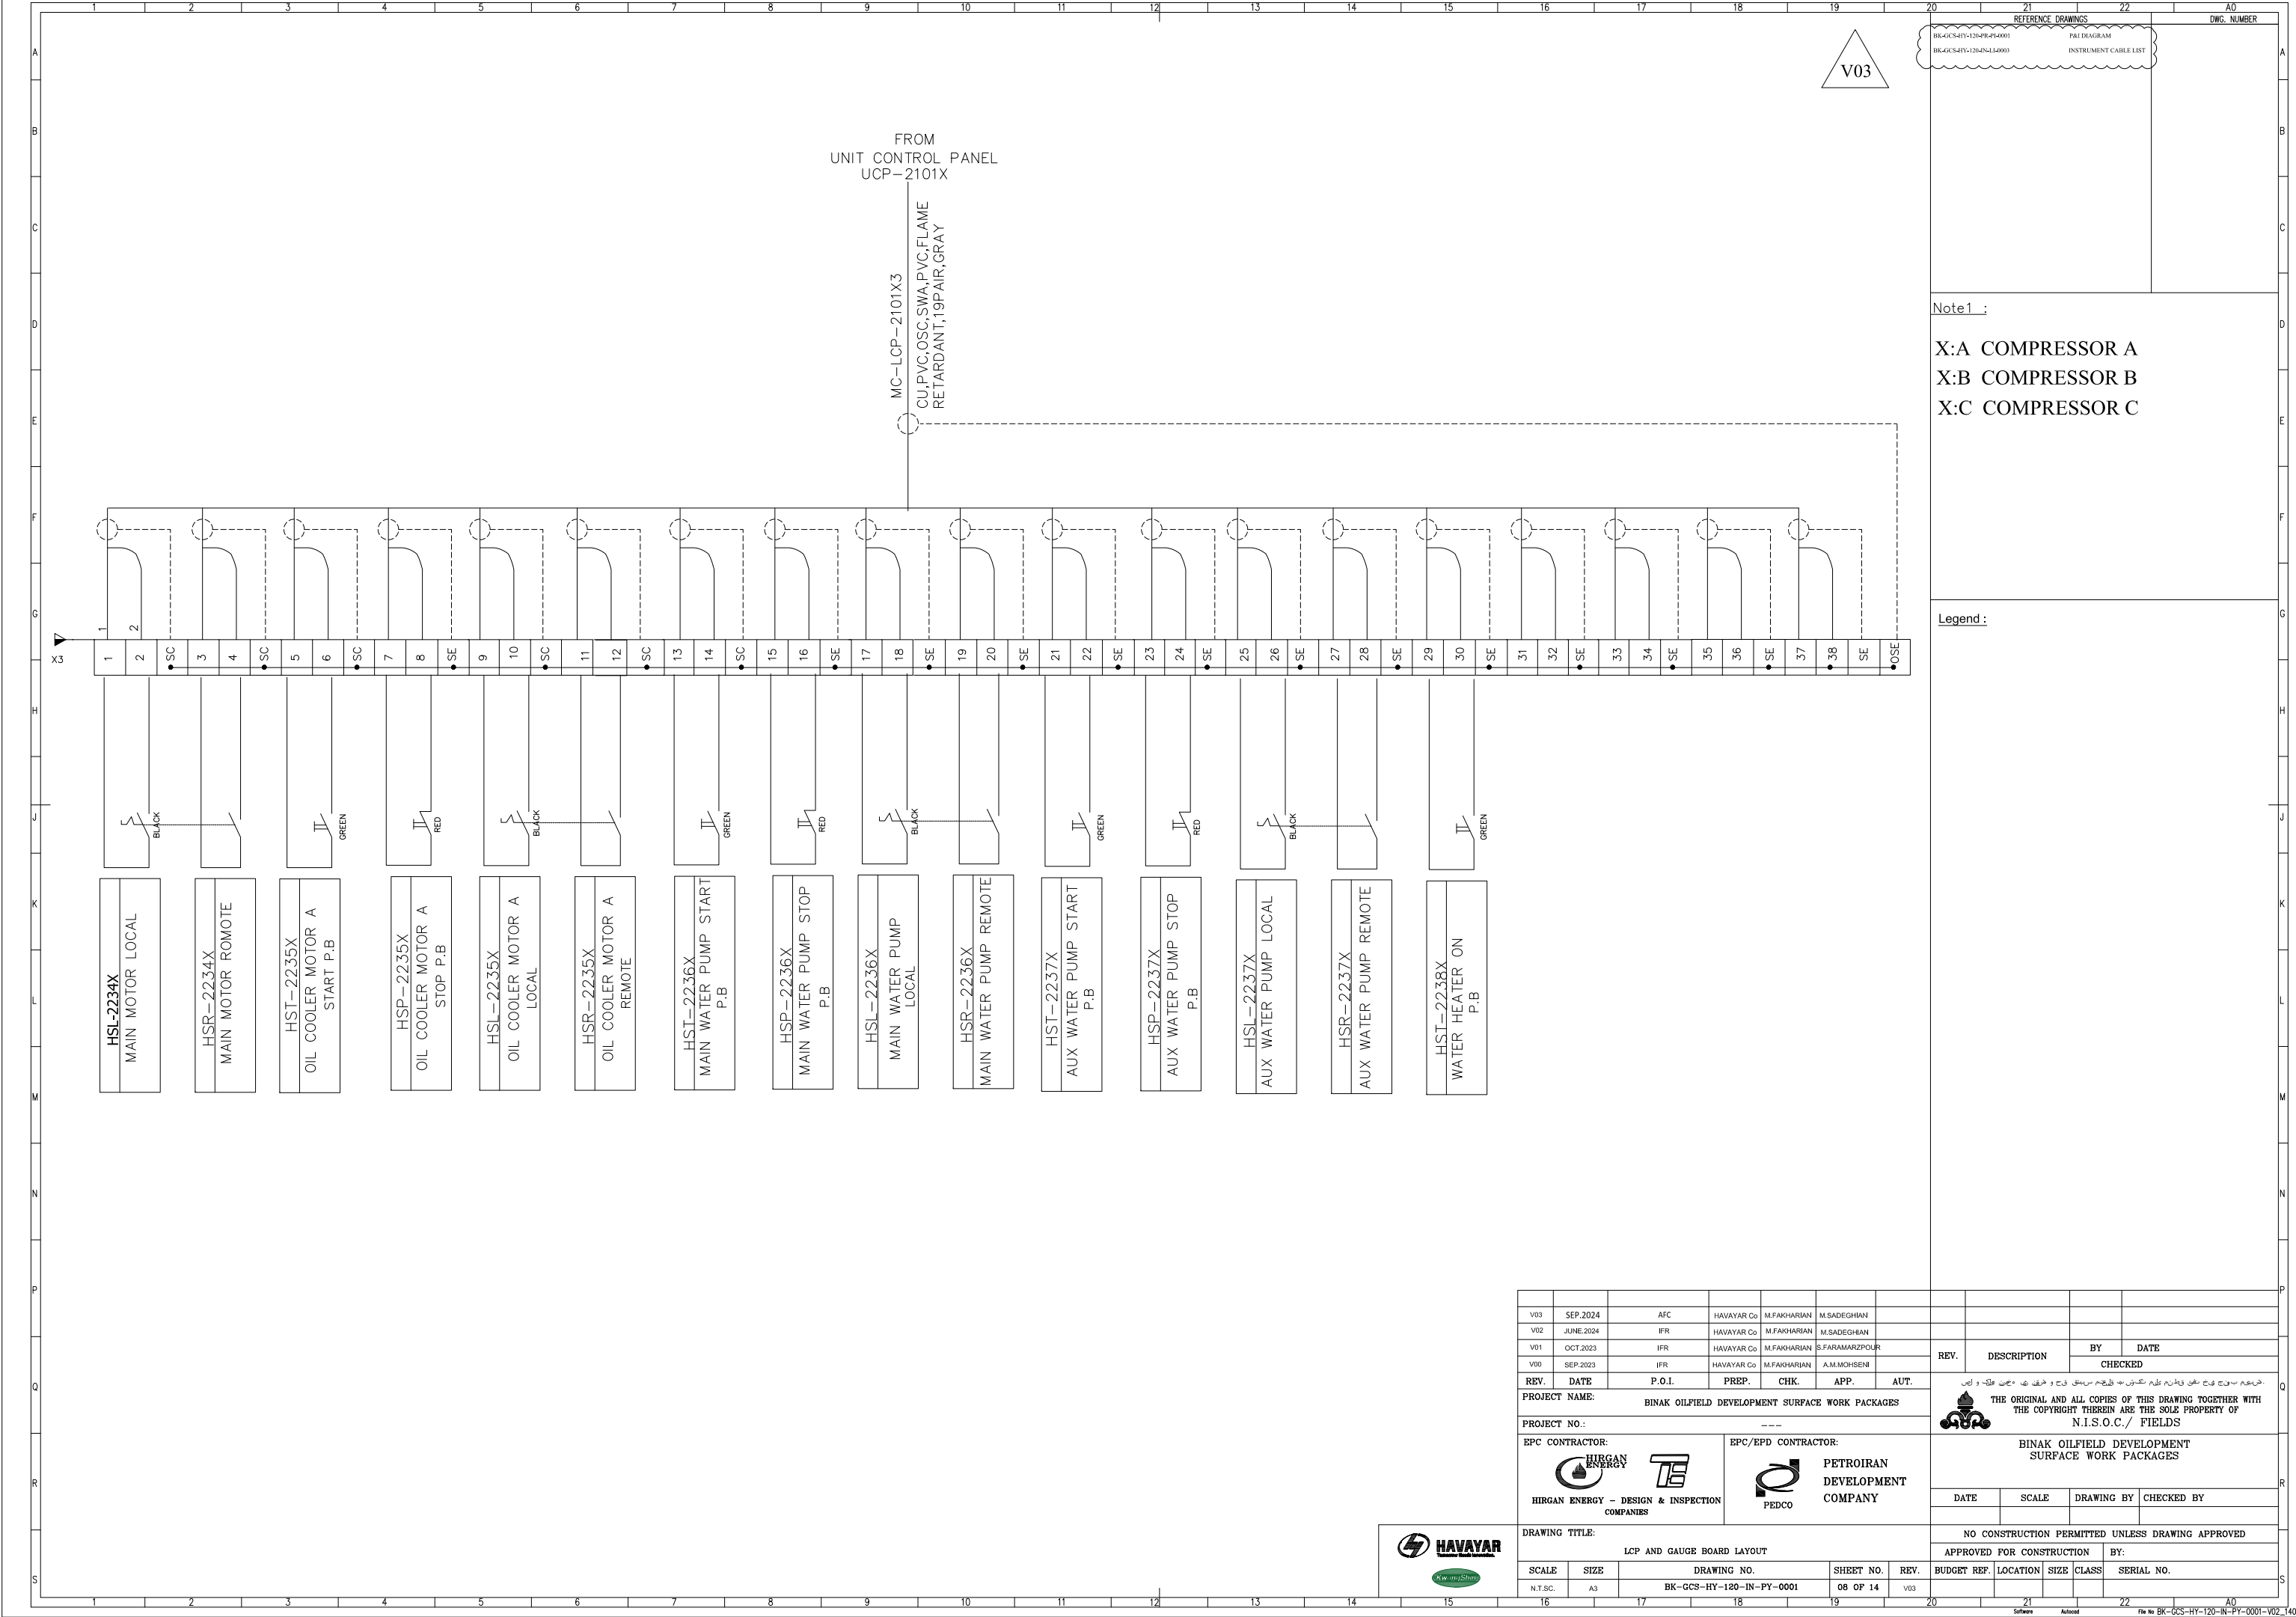



DWG. NUMBER



P&I DIAGRAM

INSTRUMENT CABLE LIST

```
X:A COMPRESSOR A
X:B COMPRESSOR B
X:C COMPRESSOR C
```


Legend :

[illegible]

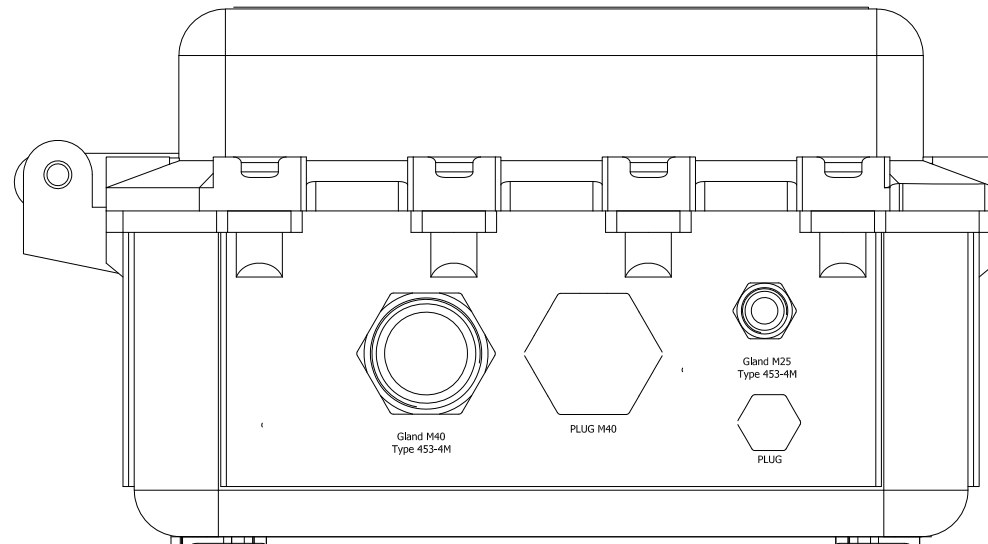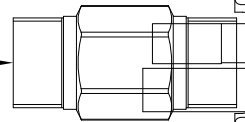

V03

External Earth Lug M8

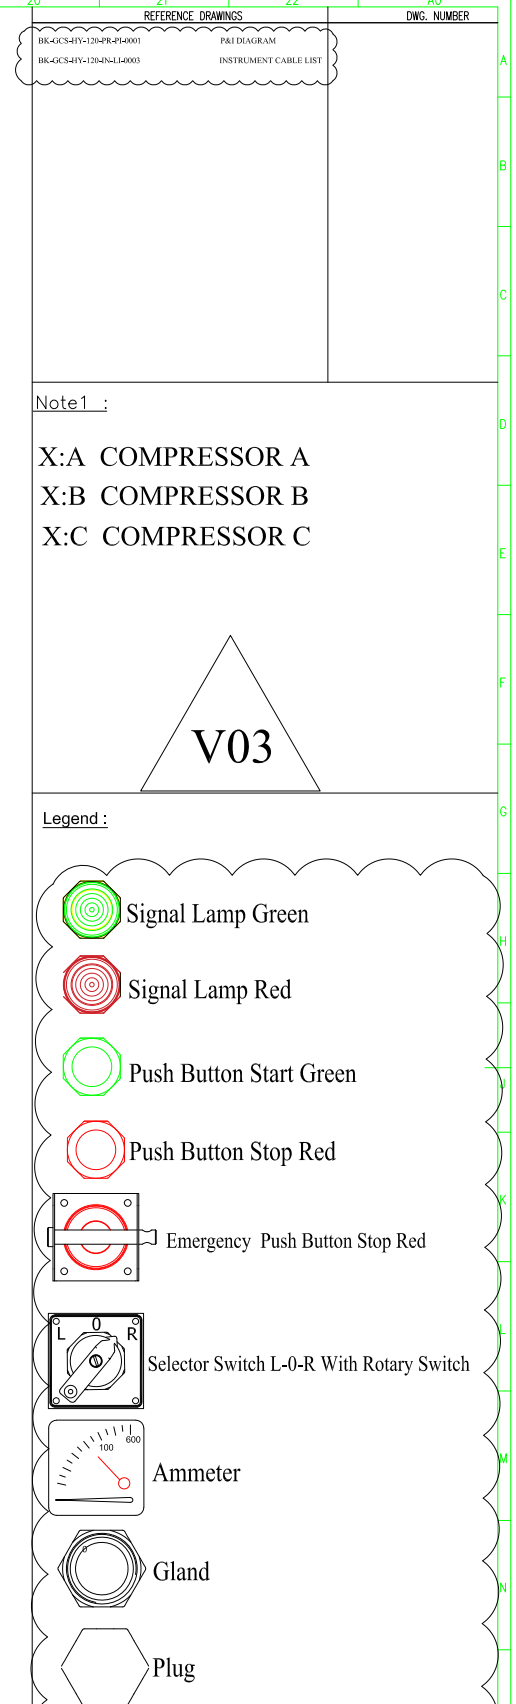[illegible]



| REFERENCE DRAWINGS | | DWG. NUMBER |
|--------------------------|-----------------------|-------------|
| BK-GCS-HY-120-PR-PL-0001 | PR1 DIAGRAM | |
| BK-GCS-HY-120-IN-LI-0003 | INSTRUMENT CABLE LIST | |


Note1 :

```
X:A COMPRESSOR A
X:B COMPRESSOR B
X:C COMPRESSOR C
```

Legend :

[illegible]

BOX 3

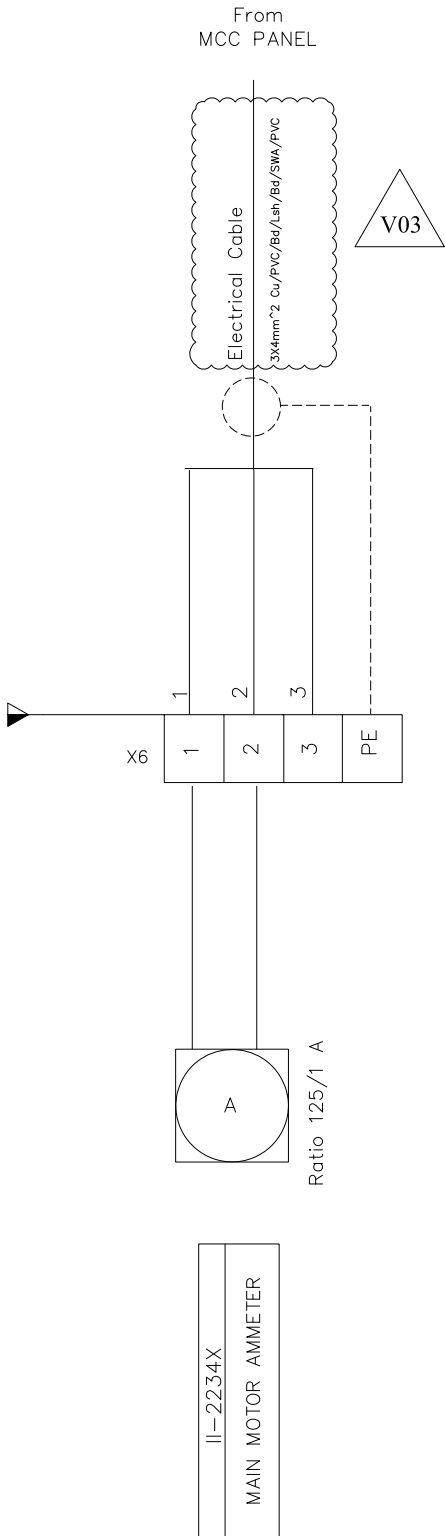

V03

| REFERENCE DRAWINGS | | DWG. NUMBER | |
|--------------------------|-----------------------|-------------|--|
| BK-GCS-HY-120-IR-PY-0001 | PAI DIAGRAM | | |
| BK-GCS-HY-120-IR-L-0003 | INSTRUMENT CABLE LIST | | |

Note1 :

X:A COMPRESSOR A
X:B COMPRESSOR B
X:C COMPRESSOR C

Legend :

| REV. | DESCRIPTION | BY | DATE |
|------|-------------|---------|------|
| | | CHECKED | |


THE ORIGINAL AND ALL COPIES OF THIS DRAWING TOGETHER WITH THE COPYRIGHT THEREIN ARE THE SOLE PROPERTY OF N.I.S.O.C./ FIELDS

BINAK OILFIELD DEVELOPMENT SURFACE WORK PACKAGES

| DATE | SCALE | DRAWING BY | CHECKED BY |
|------|-------|------------|------------|
| | | | |

NO CONSTRUCTION PERMITTED UNLESS DRAWING APPROVED

| APPROVED FOR CONSTRUCTION | | BY: | |
|---------------------------|--|-----|--|
| | | | |



| BUDGET REF. | LOCATION | SIZE | CLASS | SERIAL NO. |
|-------------|----------|------|-------|------------|
| | | | | |

| | | | | | | | |
|--|------------|--------|------------|---|----------------|-----------|--|
| V03 | SEP. 2024 | AFC | HAVAYAR Co | M.FAKHARIAN | M.SADEGHIAN | | |
| V02 | JUNE. 2024 | IFR | HAVAYAR Co | M.FAKHARIAN | M.SADEGHIAN | | |
| V01 | OCT. 2023 | IFR | HAVAYAR Co | M.FAKHARIAN | S.FARAMARZPOUR | | |
| V00 | SEP. 2023 | IFR | HAVAYAR Co | M.FAKHARIAN | A.M.MOHSENI | | |
| REV. | DATE | P.O.I. | PREP. | CHK. | APP. | AUT. | |
| PROJECT NAME: BINAK OILFIELD DEVELOPMENT SURFACE WORK PACKAGES | | | | | | | |
| PROJECT NO.: --- | | | | | | | |
| EPC CONTRACTOR: | | | | EPC/EPD CONTRACTOR: | | | |
| <div></div> <div>HIRGAN ENERGY – DESIGN & INSPECTION COMPANIES</div> | | | | <div></div> <div>PETROIRAN DEVELOPMENT COMPANY</div> | | | |
| DRAWING TITLE: LCP AND GAUGE BOARD LAYOUT | | | | | | | |
| SCALE | | SIZE | | DRAWING NO. | | SHEET NO. | |
| N.T.SC. | | A3 | | BK-GCS-HY-120-IN-PY-0001 | | 12 OF 14 | |
| | | | | | | V03 | |




| PART LIST | | | | |
|-----------|--|-----|--------------|---------|
| IN | Description | Qty | Manufacturer | Origin |
| 1 | Ex d IIB+H2 T4 Enclosure FCP241 (1x Window 60x60 mm) | 1 | S.E.M.C | Iran |
| 2 | Ex d IIB+H2 T4 Enclosure FCP241 | 3 | S.E.M.C | Iran |
| 3 | Ex d IIB+H2 Signal Lamp (Red) 24VDC | 1 | S.E.M.C | Iran |
| 4 | Ex d IIB+H2 Signal Lamp (Green) 24VDC | 13 | S.E.M.C | Iran |
| 5 | Ex d IIB+H2 Signal Lamp (Yellow) 24VDC | 1 | S.E.M.C | Iran |
| 6 | Ex d IIB+H2 Selector Switch 3Position LOR | 11 | S.E.M.C | Iran |
| 7 | Ex d IIB+H2 Push Button (Spring Return) Green (1NO+1NC) | 13 | S.E.M.C | Iran |
| 8 | Ex d IIB+H2 Push Button (Spring Return) Red (1NO+1NC) | 12 | S.E.M.C | Iran |
| 9 | Ex d IIB+H2 Emergency Stop, Mushroom Head, Stay pot (push & pull) Red (1NO+1NC) lockable | 1 | S.E.M.C | Iran |
| 10 | Ex d IIB+H2 Push Button (Spring Return) Yellow (1NO+1NC) | 1 | S.E.M.C | Iran |
| 11 | Ex d IIB+H2 Selector Switch 2Position 1Pole (0-1) | 1 | S.E.M.C | Iran |
| 12 | Ammeter "Ziegler DE72" 0~125A/CT1A Class 1.5 (Equipped with red line & 6time) | 1 | Ziegler | Germany |
| 13 | Ex d IIB+H2 Push Button " LAMP TEST " (Spring Return) Black (1NO+1NC) | 1 | S.E.M.C | Iran |
| 14 | Terminal 2.5 mm ² | 179 | RAAD | Iran |
| 15 | Earth Terminal 2.5 mm ² | 94 | RAAD | Iran |
| 16 | Ex d IIC Cable Gland M50 Type 453-4M (Armoured) BOTTOM OF JB | 4 | S.E.M.C | Iran |
| 17 | Ex d IIC Plug M50 (Type 800) (Armoured) BOTTOM OF JB | 2 | S.E.M.C | Iran |
| 18 | Ex d IIC Plug M40 (Type 800) BOTTOM OF JB | 1 | S.E.M.C | Iran |
| 19 | Ex d IIC Cable Gland M40 Type 453-4M (Armoured) BOTTOM OF JB | 1 | S.E.M.C | Iran |
| 20 | Ex d IIC Cable Gland M25 (Armoured) BOTTOM OF JB | 1 | S.E.M.C | Iran |
| 21 | Ex d IIC Plug M25 (Type 800) | 1 | S.E.M.C | Iran |
| | | | | |
| | | | | |


| |
|---|
| |</ | |
|---|

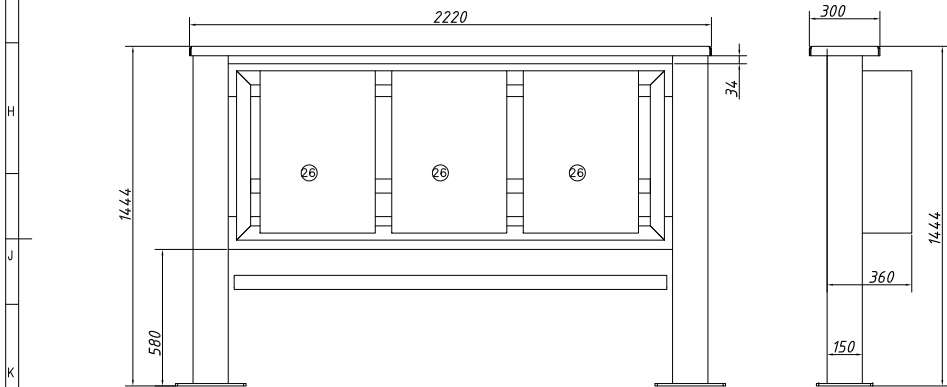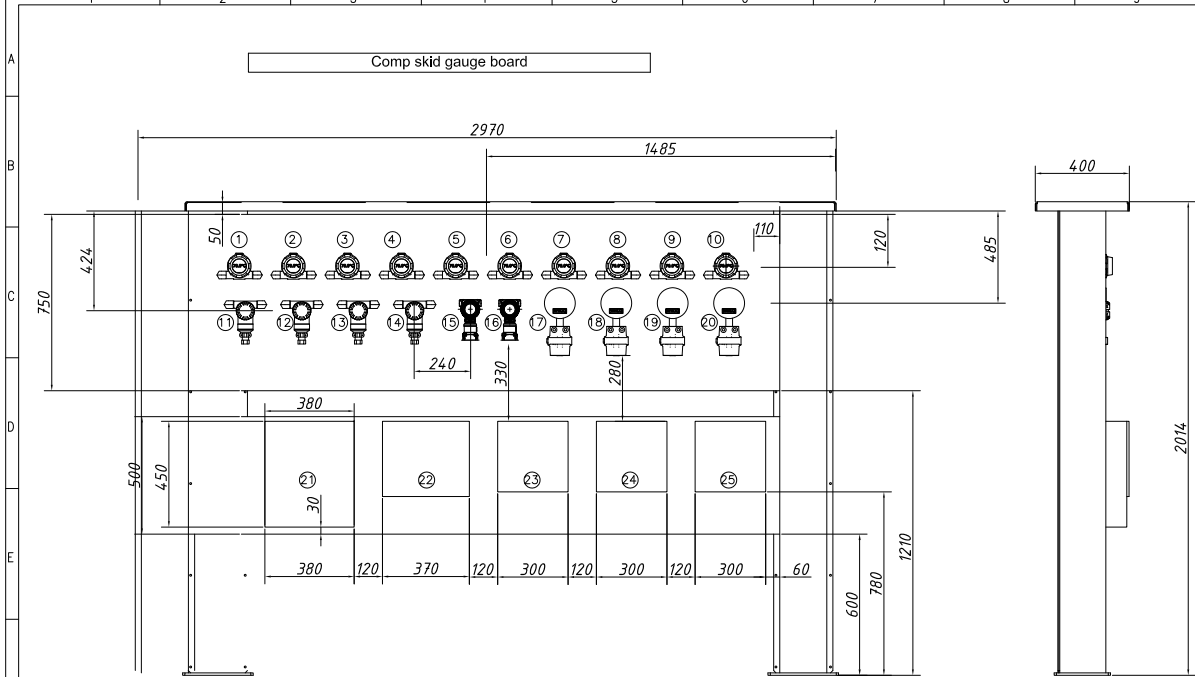

| Item No | Tag No | Remark |
|---------|-------------|-----------------------------|
| 1 | C-TT-2191X | 1STG DISCHARGE SNUBBER |
| 2 | C-TT-2194X | 2nd STAGE DISCHARGE SNUBBER |
| 3 | C-TT-2203X | OIL CRANKCASE |
| 4 | C-TT-2214X | Main Motor NDE |
| 5 | C-TT-2215X | Main Motor DE |
| 6 | C-TT-2216X | Comp DE Bearing |
| 7 | C-TT-2217X | Packing |
| 8 | C-TT-2218X | Comp NDE Bearing |
| 9 | C-TT-2219X | Packing |
| 10 | C-TT-2220X | Comp Mid Bearing |
| 11 | C-PT-2201X | Instrument Air |
| 12 | C-PT-2210X | N2 Gas Supply |
| 13 | C-PT-2211X | N2 Gas Supply |
| 14 | C-PT-2212X | N2 Gas |
| 15 | C-LT-2200X | OIL CRANKCASE |
| 16 | C-FT-2206X | WATER RETURN |
| 17 | C-PDG-2200X | N2 Gas Supply |
| 18 | C-PDG-2201X | Instrument Air |
| 19 | C-PDG-2205X | Jacket Cooling |
| 20 | C-PDG-2206X | Jacket Cooling |
| 21 | JBU-A-2102X | JB |
| 22 | JBU-A-2101X | JB |
| 23 | JBU-A-2103X | JB |
| 24 | JBU-S-2101X | JB |
| 25 | JBU-D-2101X | JB |
| 26 | LCP-2101X | LCP |

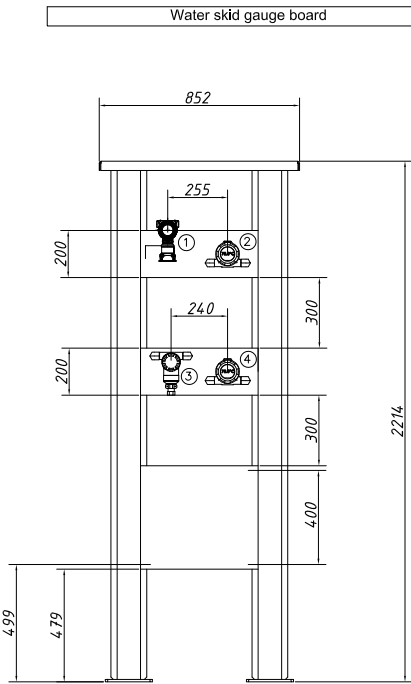

| Item No | Tag No | Remark |
|---------|------------|----------------------|
| 1 | C-TT-2213X | WATER PRESERVER SKID |
| 2 | C-TT-2221X | WATER SKID |
| 3 | C-PT-2220X | WATER SKID |
| 4 | C-LT-2213X | WATER PRESERVER SKID |

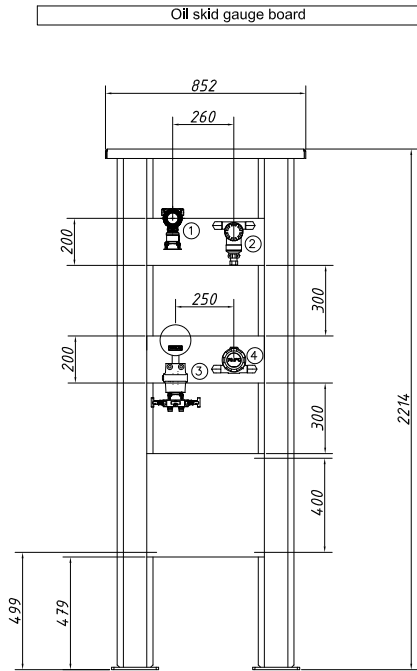

| Item No | Tag No | Remark |
|---------|-------------|-----------------|
| 1 | C-PDT-2204X | OIL SKID FILTER |
| 2 | C-PT-2204X | OIL SKID |
| 3 | C-PDG-2204X | OIL SKID FILTER |
| 4 | C-TT-2204X | OIL SKID |

| REFERENCE DRAWINGS | DWG. NUMBER |
|---|--------------------------------------|
| IR-GCS-HY-120-PI-05-0001 IR-GCS-HY-120-AN-1-0003 | PAI DIAGRAM INSTRUMENT CABLE LIST |

Note1 :

X:A COMPRESSOR A
X:B COMPRESSOR B
X:C COMPRESSOR C

Legend :

| REV. | DATE | P.O.I. | PREP. | CHK. | APP. | AUT. | DESCRIPTION | BY | DATE |
|---|-----------|--------|------------|-------------|----------------|------|---|----|------|
| V03 | SEP.2024 | AFC | HAVAYAR Co | M.FAKHARIAN | M.SADEGHIAN | | | | |
| V02 | JUNE.2024 | IFR | HAVAYAR Co | M.FAKHARIAN | M.SADEGHIAN | | | | |
| V01 | OCT.2023 | IFR | HAVAYAR Co | M.FAKHARIAN | S.FARAMARZPOUR | | | | |
| V00 | SEP.2023 | IFR | HAVAYAR Co | M.FAKHARIAN | A.M.MOHSENI | | | | |
| PROJECT NAME: BINAK OILFIELD DEVELOPMENT SURFACE WORK PACKAGES | | | | | | | CHECKED | | |
| PROJECT NO.: --- | | | | | | | DATE | | |
| EPC CONTRACTOR: HIRGAN ENERGY | | | | | | | SCALE | | |
| EPC/EPD CONTRACTOR: PETROIRAN DEVELOPMENT COMPANY | | | | | | | DRAWING BY | | |
| DRAWING TITLE: LCP AND GAUGE BOARD LAYOUT | | | | | | | CHECKED BY | | |
| SCALE: N.T.S.C. SIZE: A3 DRAWING NO: BK-GCS-HY-120-IN-PY-0001 SHEET NO: 14 OF 14 REV: V03 | | | | | | | NO CONSTRUCTION PERMITTED UNLESS DRAWING APPROVED | | |
| | | | | | | | APPROVED FOR CONSTRUCTION BY: | | |
| | | | | | | | BUDGET REF. LOCATION SIZE CLASS SERIAL NO. | | |



THE ORIGINAL AND ALL COPIES OF THIS DRAWING TOGETHER WITH THE COPYRIGHT THEREIN ARE THE SOLE PROPERTY OF N.I.S.O.C./ FIELDS

DATE SCALE DRAWING BY CHECKED BY

NO CONSTRUCTION PERMITTED UNLESS DRAWING APPROVED

APPROVED FOR CONSTRUCTION BY:

BUDGET REF. LOCATION SIZE CLASS SERIAL NO.