


[illegible]


```
X:A COMPRESSOR A
X:B COMPRESSOR B
X:C COMPRESSOR C
```

WIRE 1.5mm² BLACK
Ammeter 2.5mm² BLACK
Silicone wire SIMCO brand


Lamp Signal

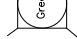


Push Bottom




Selector switch

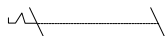


Ammeter

[illegible]

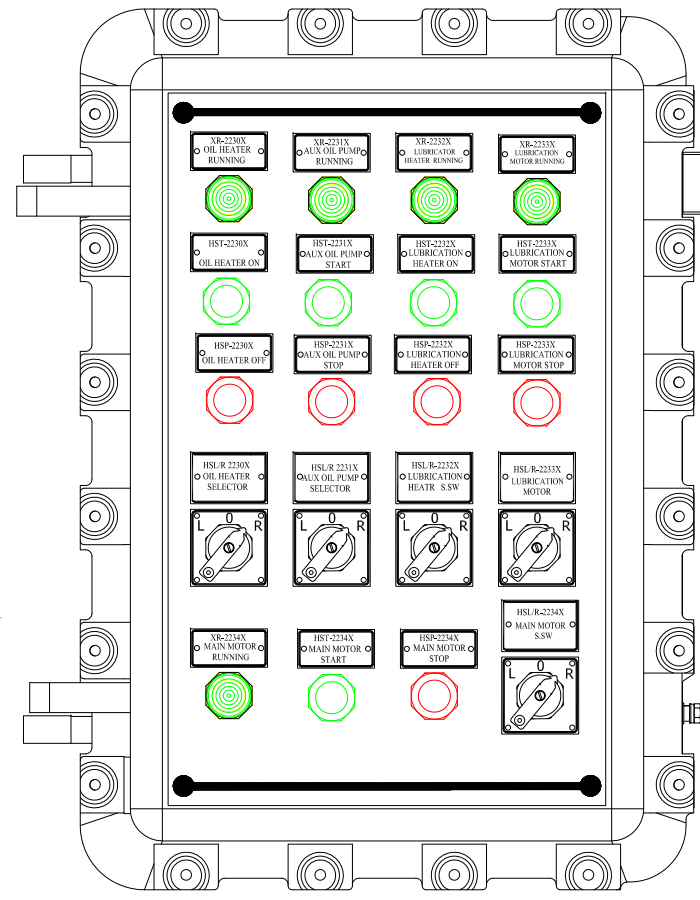


Front View

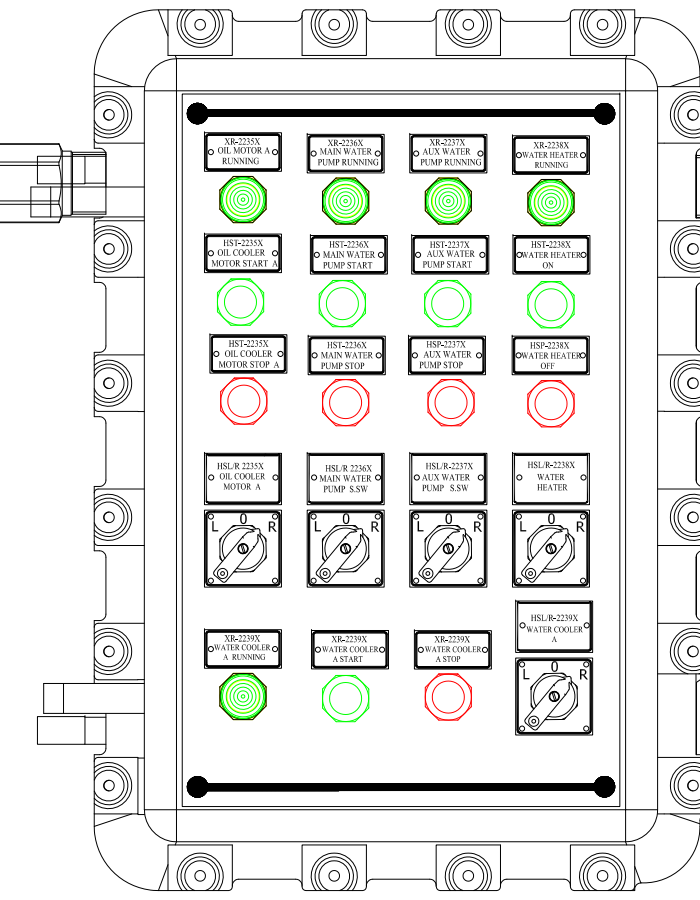

Front View

External Earth Lug M8

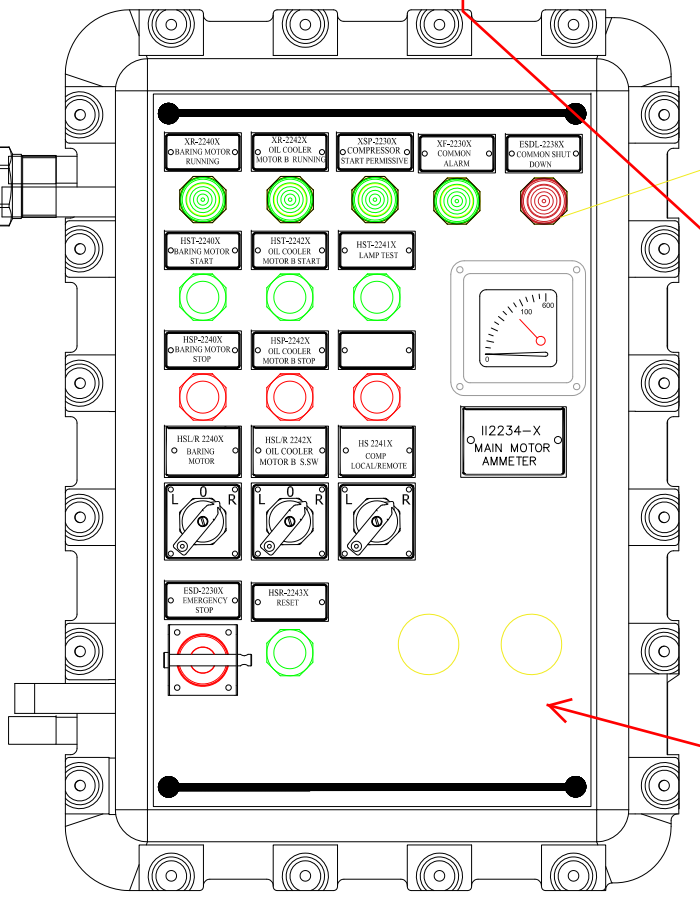

Front View


Legend to be added. PB, selector switch ,....
HY reply: Added

Note1 :
X:A COMPRESSOR A
X:B COMPRESSOR B
X:C COMPRESSOR C

Legend :

Spare space to be considered.
HY reply: Confirmed.

REV.	DATE	P.O.I.	PREP.	CHK.	APP.	AUT.	DESCRIPTION	BY	DATE
V02	JUNE.2024		IFR	HAVAYAR	M.FAKHARIAN	M.SADEGHIAN			
V01	OCT.2023		IFR	HAVAYAR	M.FAKHARIAN	E.FARAMARZPOUR			
V00	SEP.2023		IFR	HAVAYAR	M.FAKHARIAN	A.M.MOHSENI			
PROJECT NAME: BINAK OILFIELD DEVELOPMENT SURFACE WORK PACKAGES							CHECKED		
PROJECT NO.: ---							THE ORIGINAL AND ALL COPIES OF THIS DRAWING TOGETHER WITH THE COPYRIGHT THEREIN ARE THE SOLE PROPERTY OF N.I.S.O.C./ FIELDS		
EPC CONTRACTOR: HIRGAN ENERGY - DESIGN & INSPECTION COMPANIES							BINAK OILFIELD DEVELOPMENT SURFACE WORK PACKAGES		
EPC/EPD CONTRACTOR: PETROIRAN DEVELOPMENT COMPANY							DATE	SCALE	DRAWING BY
DRAWING TITLE: LCP AND GAUGE BOARD LAYOUT							CHECKED BY		
SCALE: N.T.S.C. A3							NO CONSTRUCTION PERMITTED UNLESS DRAWING APPROVED		
DRAWING NO. BK-GCS-HY-120-IN-PY-0001							APPROVED FOR CONSTRUCTION BY:		
SHEET NO. 02 OF 12							BUDGET REF.	LOCATION	SIZE
REV. V02							CLASS	SERIAL NO.	

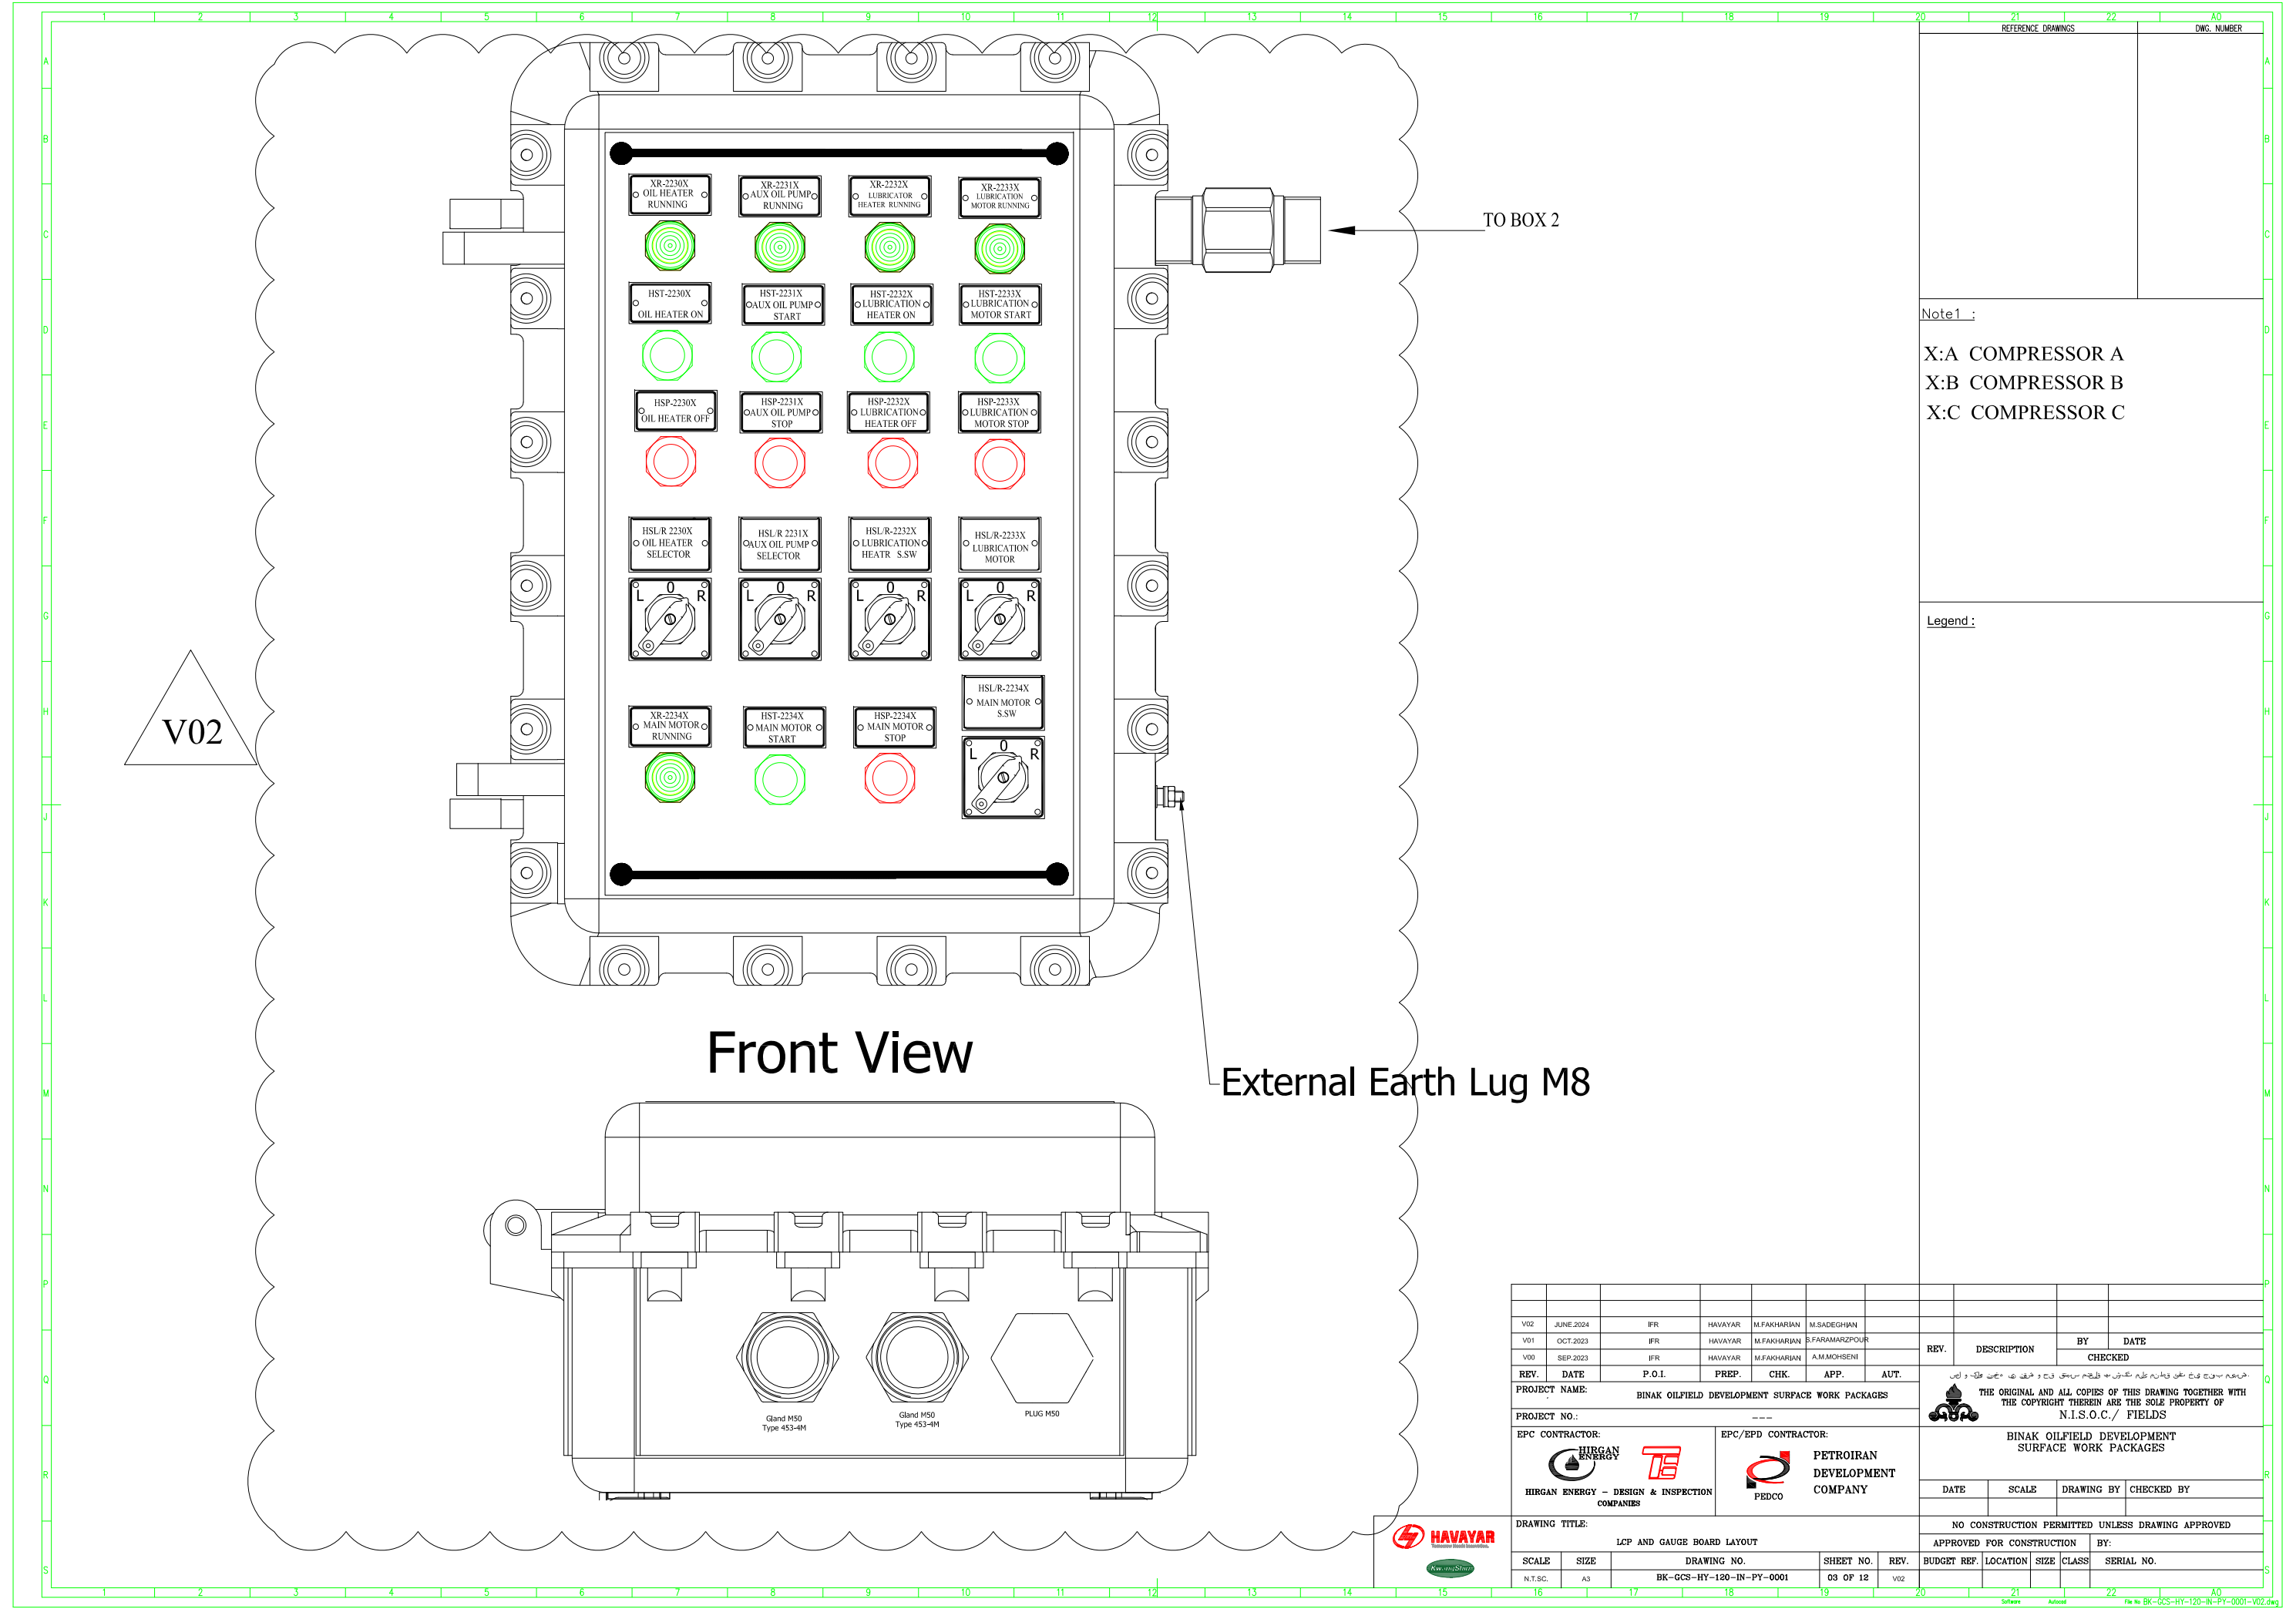

Note1 :

X:A COMPRESSOR A
X:B COMPRESSOR B
X:C COMPRESSOR C


Legend :

FROM BOX 1

TO BOX 3

V02


External Earth Lug M8

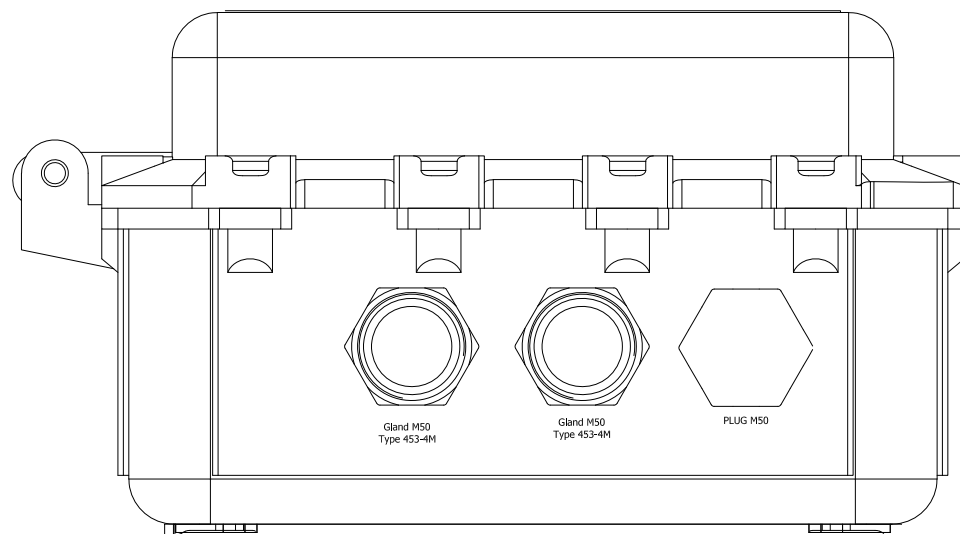

--	--	----	--	--	--	--	--	--	--	--	--

V02

FROM BOX 2

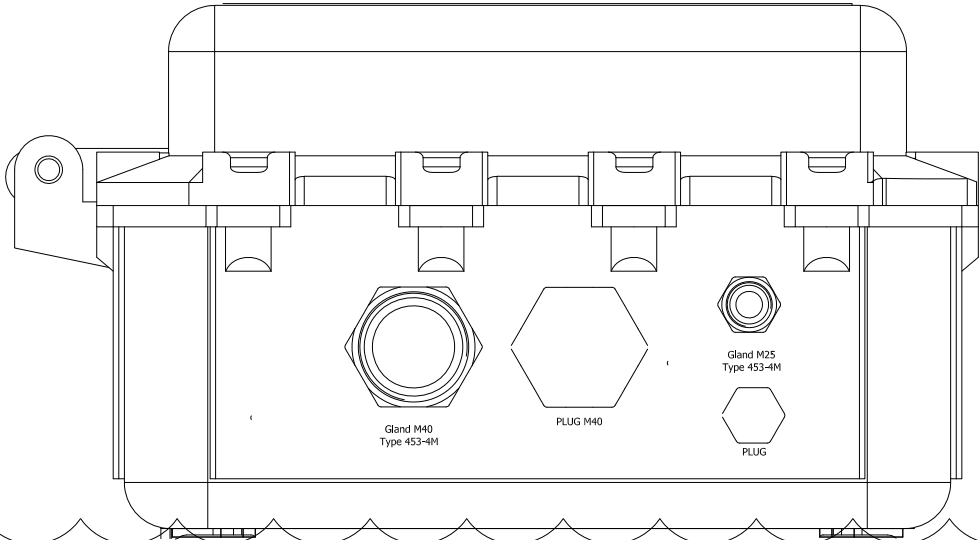

External Earth Lug M8

REFERENCE DRAWINGS	DWG. NUMBER


Note1 :
X:A COMPRESSOR A
X:B COMPRESSOR B
X:C COMPRESSOR C


Legend :

--	--	





THE ORIGINAL AND ALL COPIES OF THIS DRAWING TOGETHER WITH THE COPYRIGHT THEREIN ARE THE SOLE PROPERTY OF N.I.S.O.C./ FIELDS

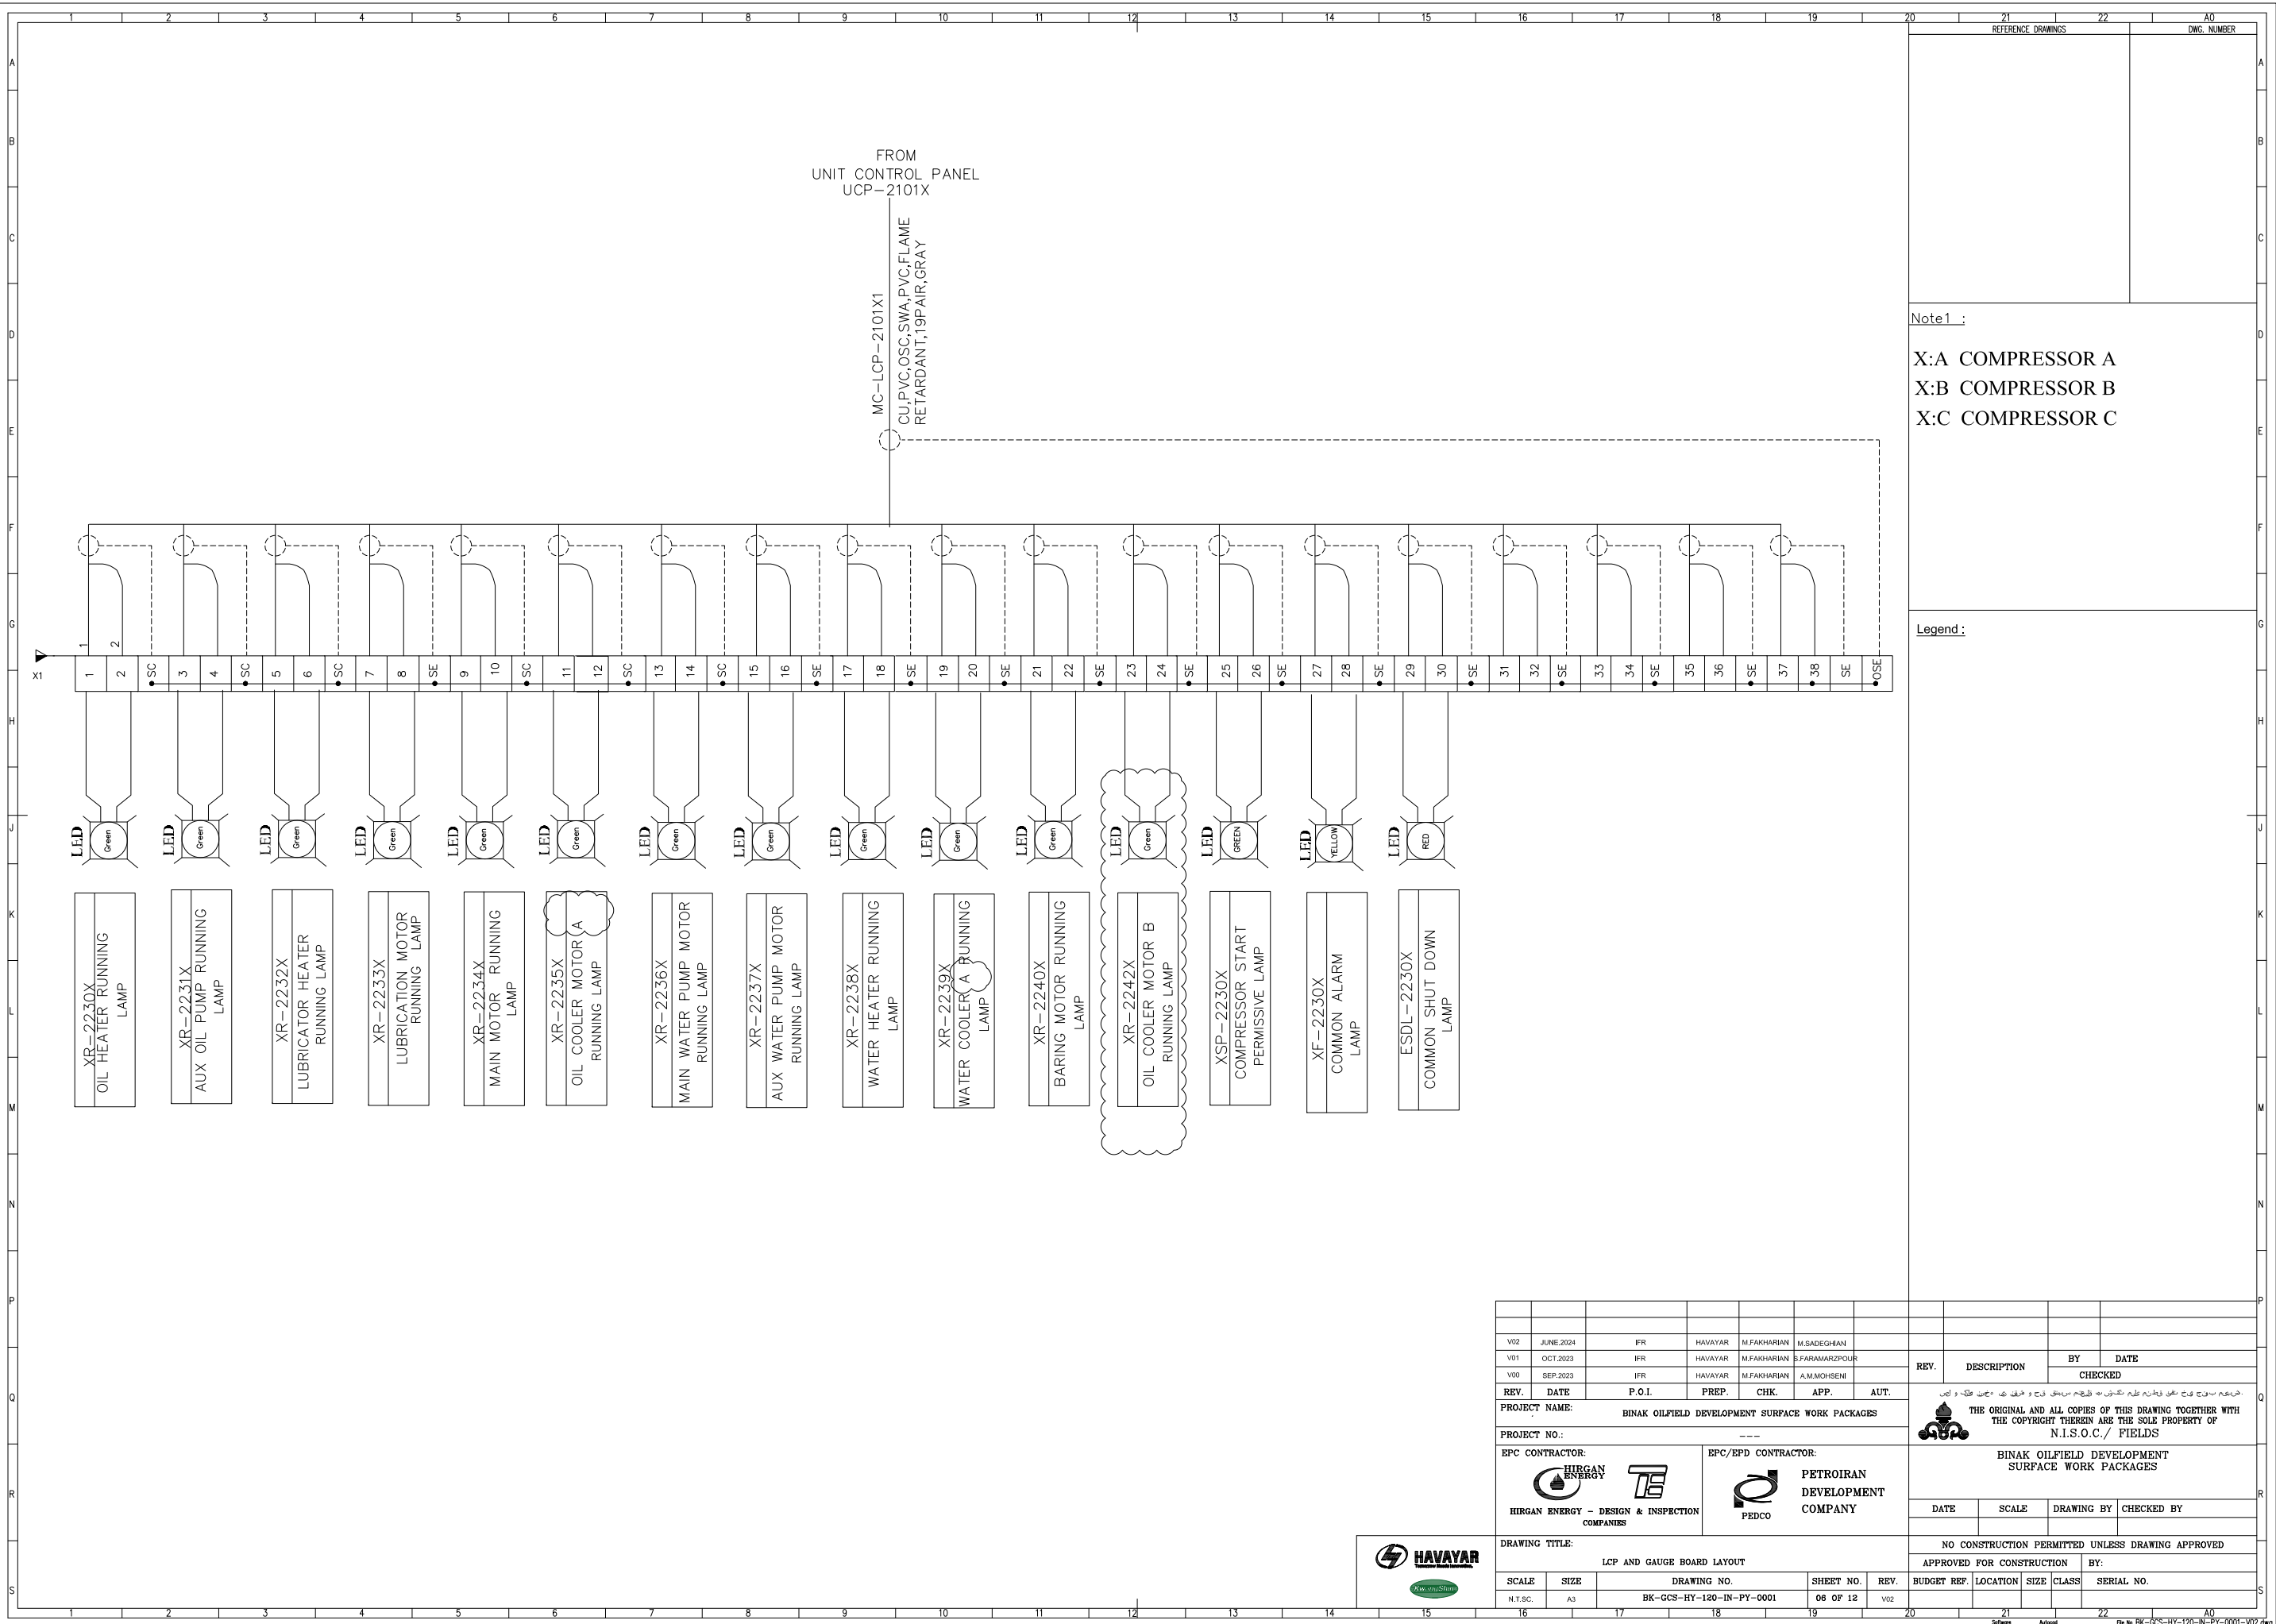

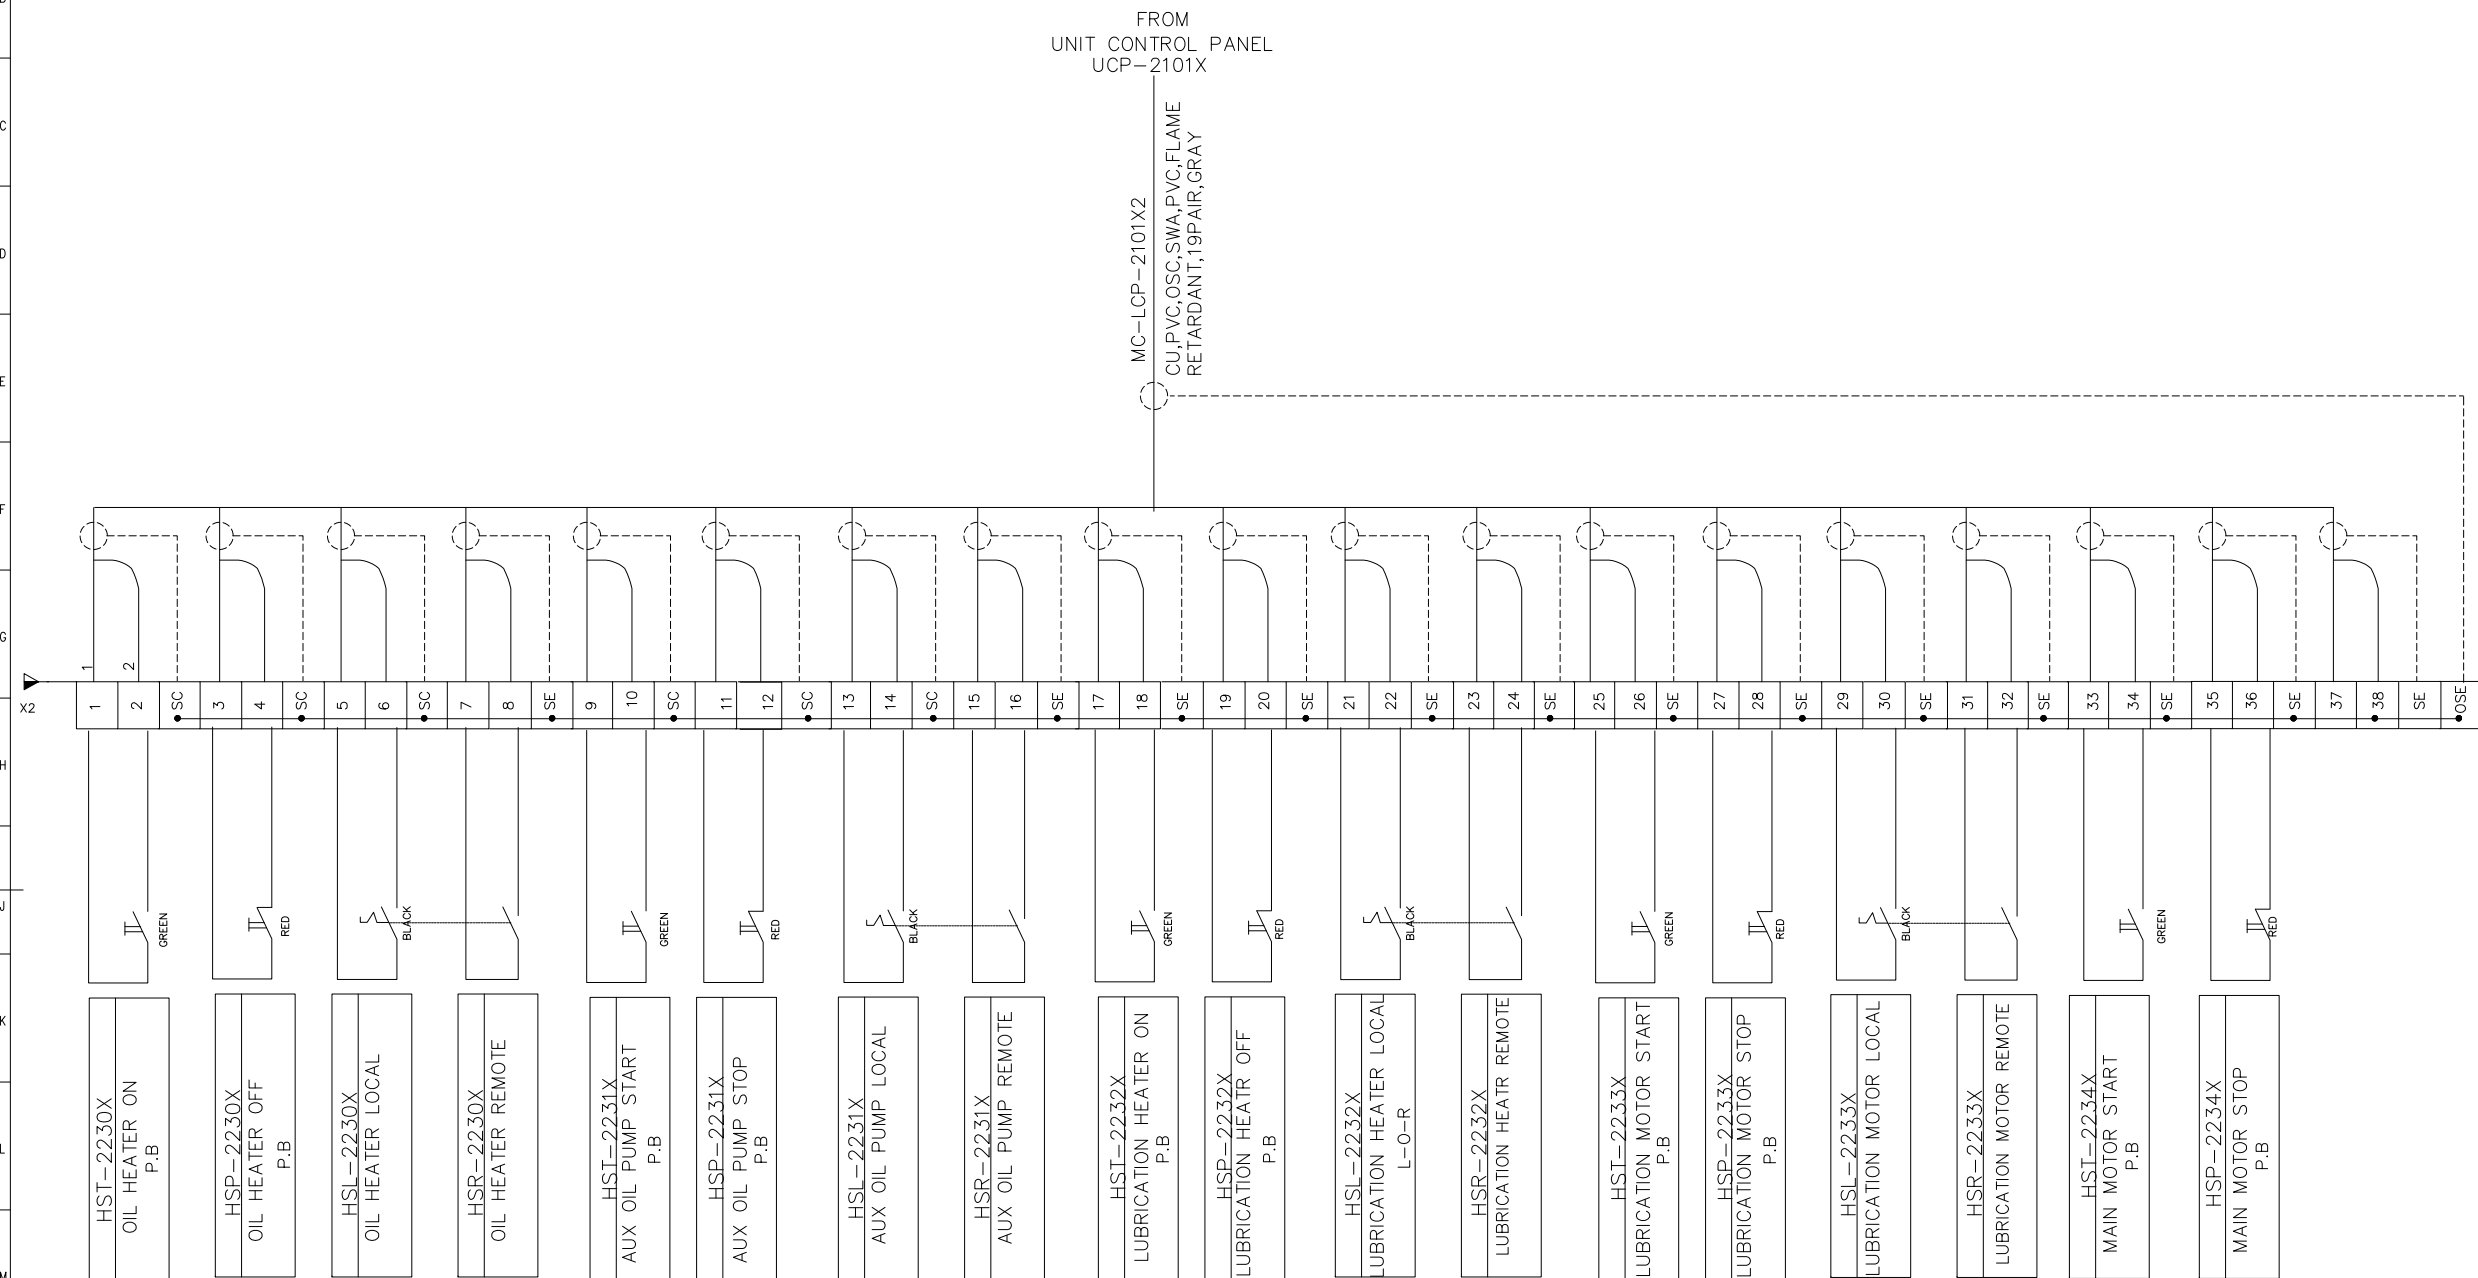[illegible]

Legend :

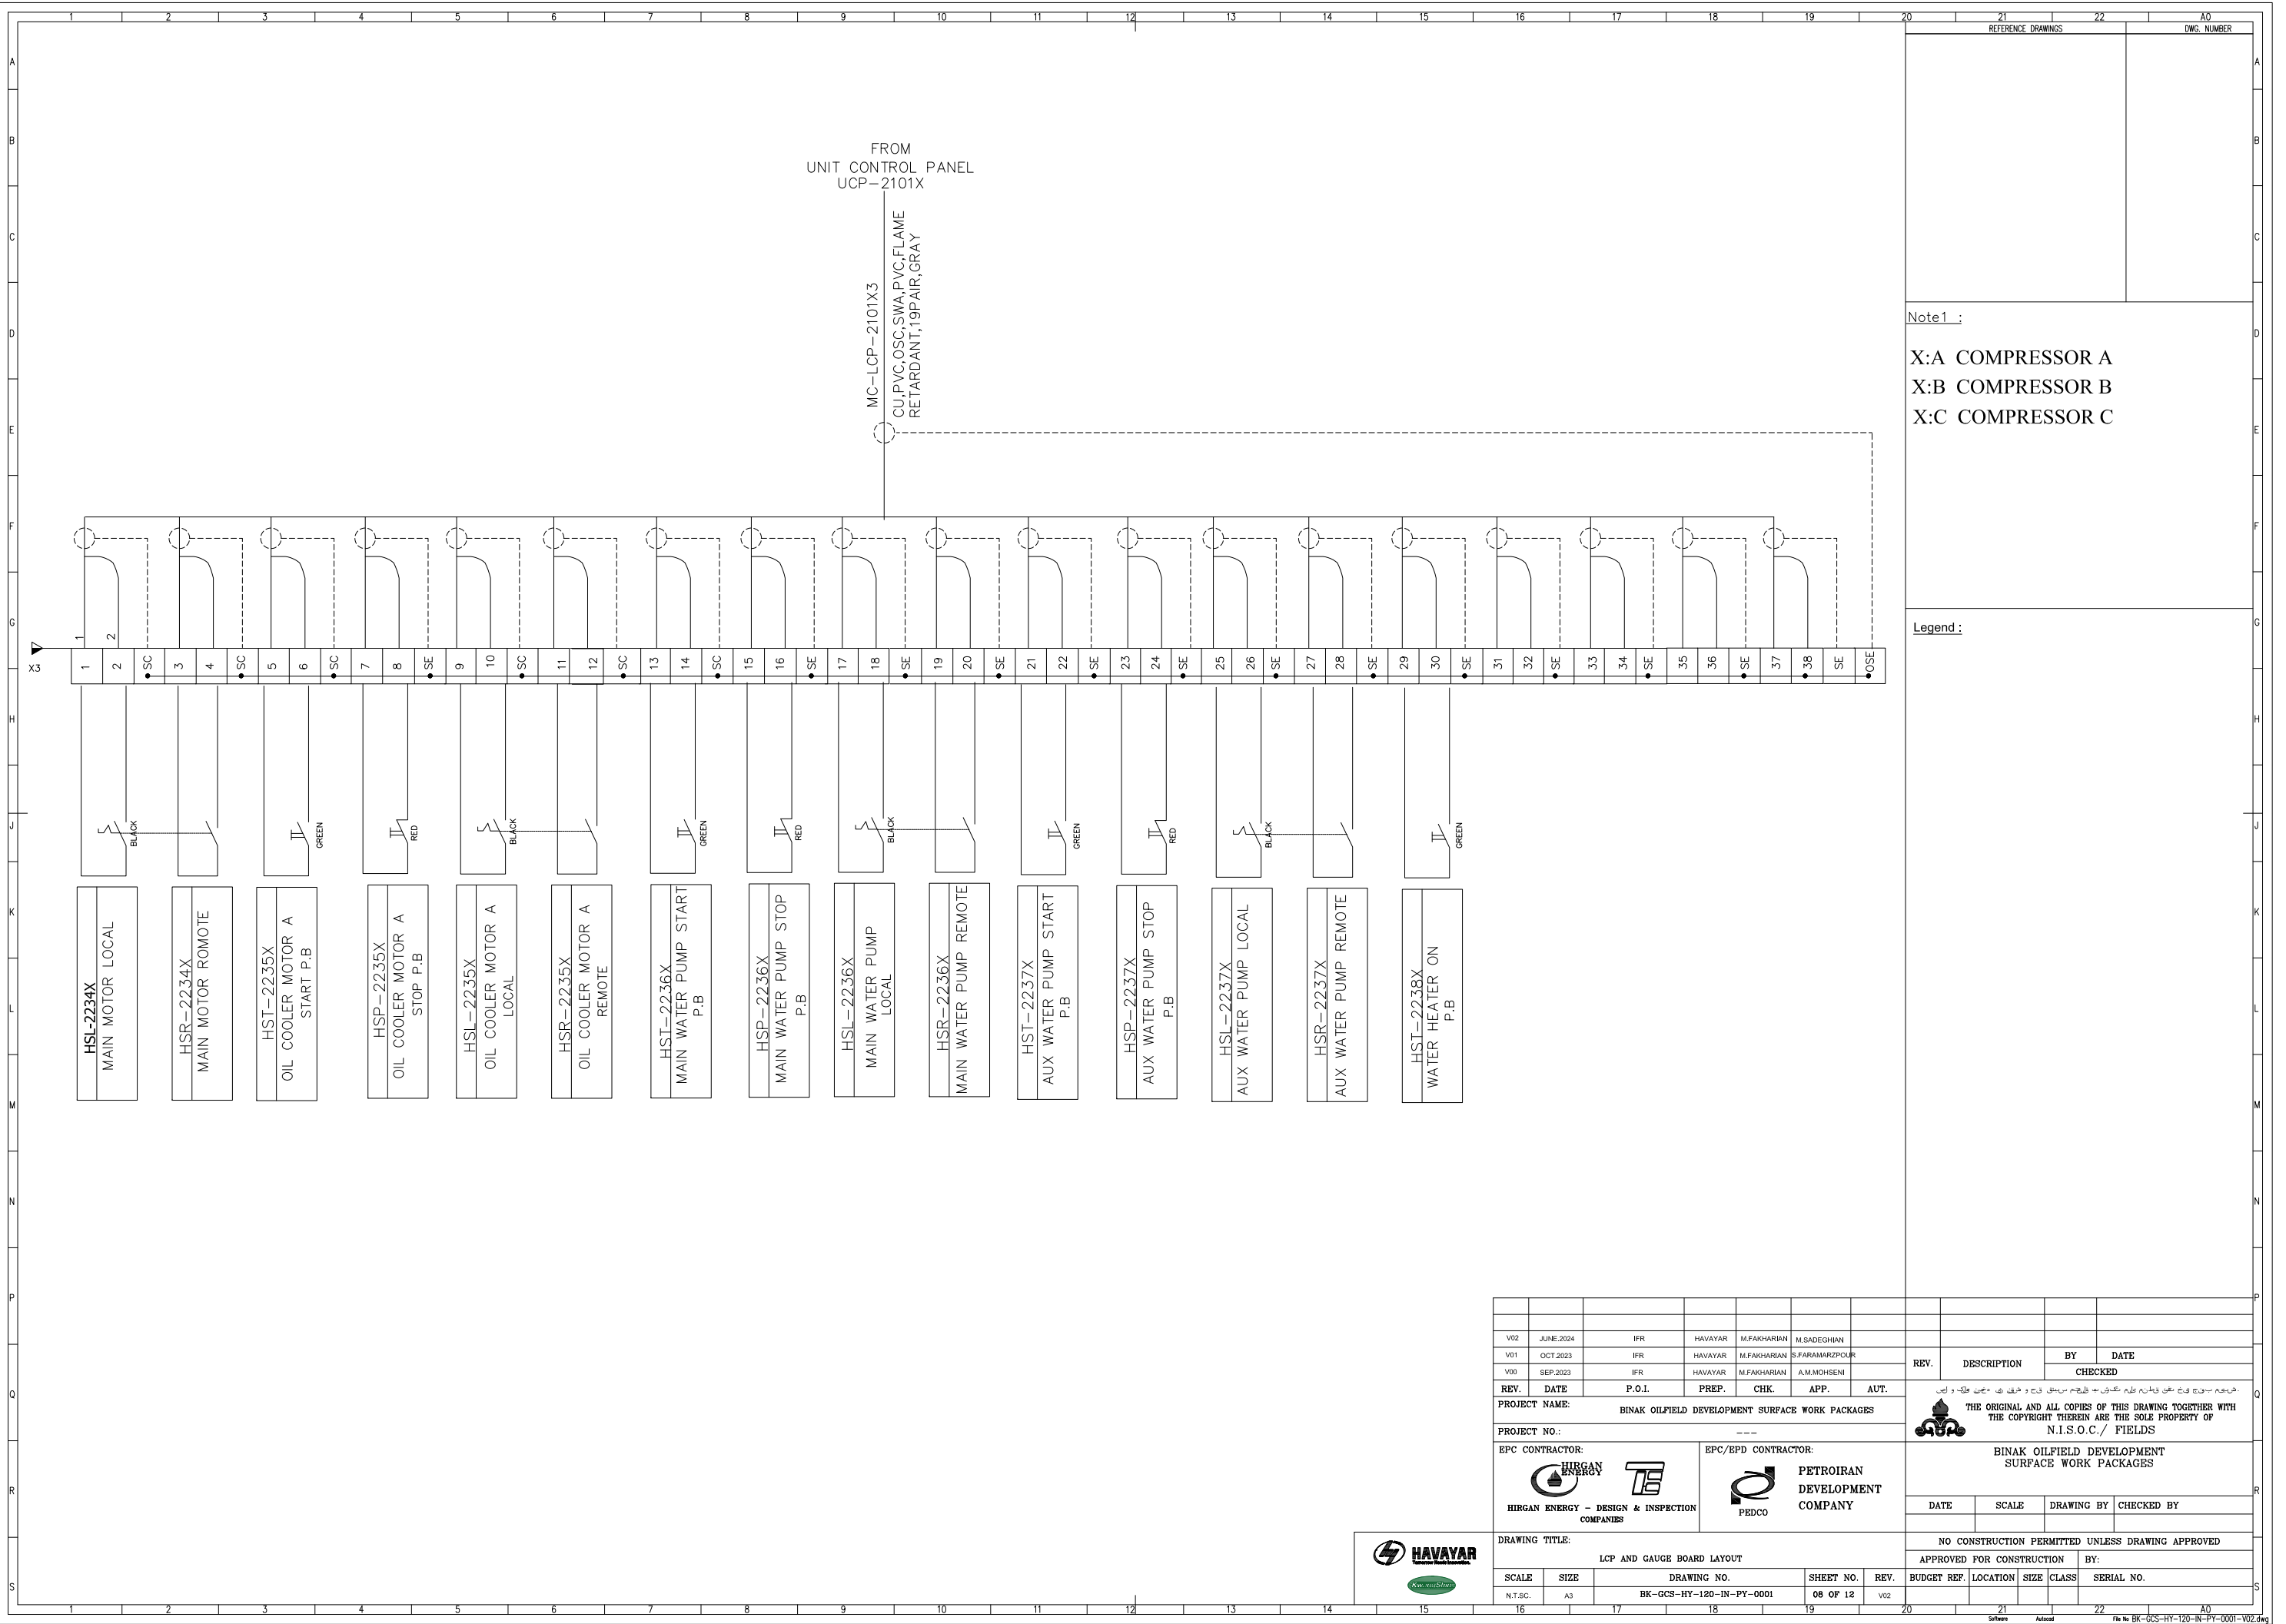


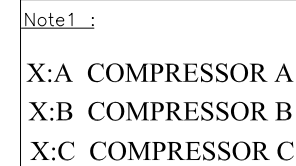

Legend :


HAVAYAR

Kw.mqShine

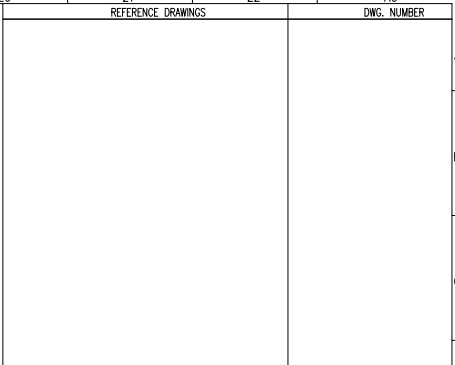

X:A	COMPRESSOR A
X:B	COMPRESSOR B
X:C	COMPRESSOR C



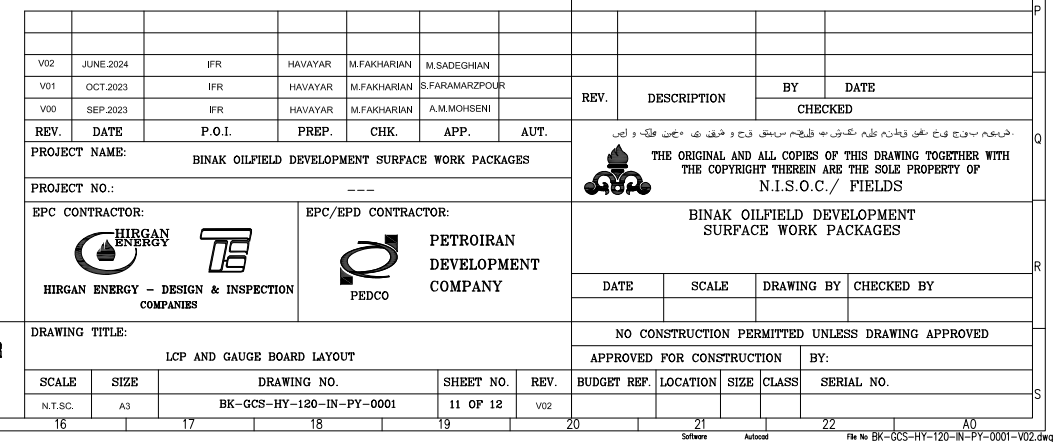

PART LIST				
IN	Description	Qty	Manufacturer	Origin
1	Ex d IIB+H2 T4 Enclosure FCP241 (1x Window 60x60 mm)	1	S.E.M.C	Iran
2	Ex d IIB+H2 T4 Enclosure FCP241	3	S.E.M.C	Iran
3	Ex d IIB+H2 Signal Lamp (Red) 24VDC	1	S.E.M.C	Iran
4	Ex d IIB+H2 Signal Lamp (Green) 24VDC	13	S.E.M.C	Iran
5	Ex d IIB+H2 Signal Lamp (Yellow) 24VDC	1	S.E.M.C	Iran
6	Ex d IIB+H2 Selector Switch 3Position LOR	11	S.E.M.C	Iran
7	Ex d IIB+H2 Push Button (Spring Return) Green (1NO+1NC)	11	S.E.M.C	Iran
8	Ex d IIB+H2 Push Button (Spring Return) Red (1NO+1NC)	11	S.E.M.C	Iran
9	Ex d IIB+H2 Emergency Stop, Mushroom Head, Stay pot (push & pull) Red (1NO+1NC) lockable	1	S.E.M.C	Iran
10	Ex d IIB+H2 Push Button (Spring Return) Yellow (1NO+1NC)	1	S.E.M.C	Iran
11	Ex d IIB+H2 Selector Switch 2Position 1Pole (0-1)	1	S.E.M.C	Iran
12	Ammeter "Ziegler DE72" 0~125A/CT1A Class 1.5 (Equipped with red line & 6time)	1	Ziegler	Germany
13	Ex d IIB+H2 Push Button "LAMP TEST" (Spring Return) Black (1NO+1NC)	1	S.E.M.C	Iran
14	Terminal 2.5 mm ²	179	RAAD	Iran
15	Earth Terminal 2.5 mm ²	94	RAAD	Iran
16	Ex d IIC Cable Gland M50 Type 453-4M (Armoured) BOTTOM OF JB	4	S.E.M.C	Iran
17	Ex d IIC Plug M50 (Type 800) (Armoured) BOTTOM OF JB	2	S.E.M.C	Iran
18	Ex d IIC Plug M40 (Type 800) BOTTOM OF JB	1	S.E.M.C	Iran
19	Ex d IIC Cable Gland M40 Type 453-4M (Armoured) BOTTOM OF JB	1	S.E.M.C	Iran
20	Ex d IIC Cable Gland M25 (Armoured) BOTTOM OF JB	1	S.E.M.C	Iran
21	Ex d IIC Plug M25 (Type 800)	1	S.E.M.C	Iran
22	Silicone Wire	-	SIMCO	Iran

This list is not compatible with schematic page 2. to be modified

Spare parts to be counted in MTO.

HY reply:Spare part document is separate in VPIS. Spare of LCP will be considered in related doc.

Discrepancy with
page 2.

HY reply: That is correct . color of drawing is not correct. one lamp is yellow.

Note1 :

X:A COMPRESSOR A

X:B COMPRESSOR B

X:C COMPRESSOR C

Legend :